


Section 33 Township 29 Range 6W
Well No. 1 Bell
Company Mid-States & Armer

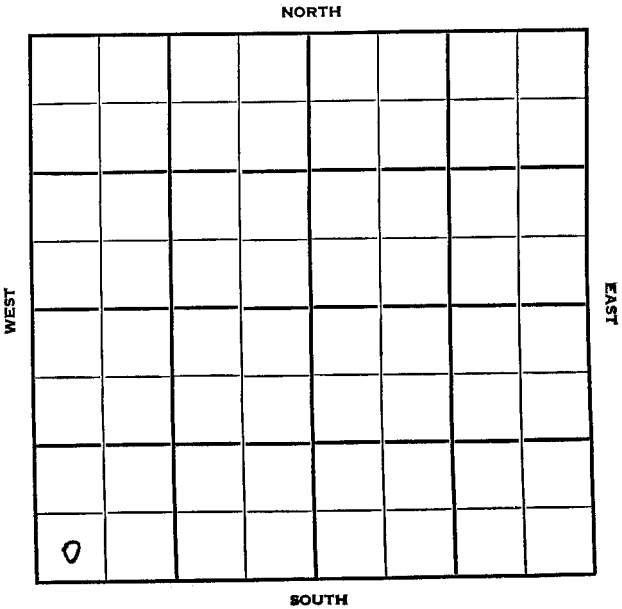

information brought forward


1954

7/14

5" @ 3685

CO to 3687 P/ 9 bo 11 hr. 250 A F/ 3
boph 1% sw F/ 57 bo 24 hrs. F/ 27 bo
17 hr. F/ 3 boph 8% wtr. F/ 83 bo
16 bw 24 hr. Comp. F. 153 bopd 15% sw

COMPLETED

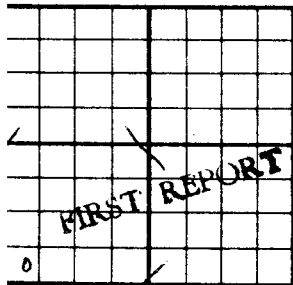County **Kingman** State **Kansas**Sec. **33** (Blk. Twp.) **29** (Sur. Rge.) **6W** Map No.Operator **Mid-States & Armer**Well No. **1** Farm **Bell**Elev. Location **SW SW SW****330** Ft. From **S** Line **SW****330** Ft. From **W** Line Quarter1st. Report **MAY 12 1954**

Completion

Remarks

Spudding Date **5-10-54**Orig. Data **Rosedale Pool****8" @ 166 WOC**


I. G. McGUIRE

County Kineman State Kansas
 Sec. 33 (Blk.) 29 (Sur.) 6W Map No.

Operator Mid-States & Armer

Well No. 1 Farm Bell

Elev. 1456 Location SW SW SW

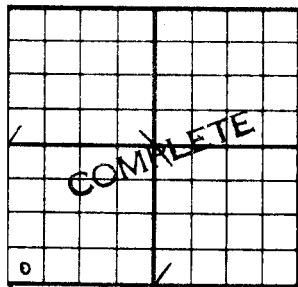

330 Ft. From S Line SW

330 Ft. From W Line Quarter

1st. Report

Completion JUL 14 1954

Remarks Rosedale Pool

Spudding Date 5-10-54

Drig. Data Oil well TD 3687

8" @ 166 Doug. 3016 Lans. 3221

KC 3500 DST 3507-20 open 1 hr.

Rec. 150' o & gcm 418# DST 3543-58

open 1 hr. Rec. 300' ho & gcm 300' sw

1361# DST 3683-87 open 1 hr. Rec. 150'

oil 1570# TD 3687 5" @ 3685

CO to 3687 P/ 9 bo 11 hr. 250 A

F/ 3 boph 1% sw F/ 57 bo 24 hr.

F/ 27 bo 17 hr. F/ 3 boph 8% wtr.

F/ 83 bo 16 bw 24 hr.

Comp. F. 153 bopd 15% sw

J. G. McGE