


Kingman

KANSAS

SECTION 33 TOWNSHIP 29S RANGE 6W

WELL NO. #5 Bell

COMPANY McKnab & Lindsay

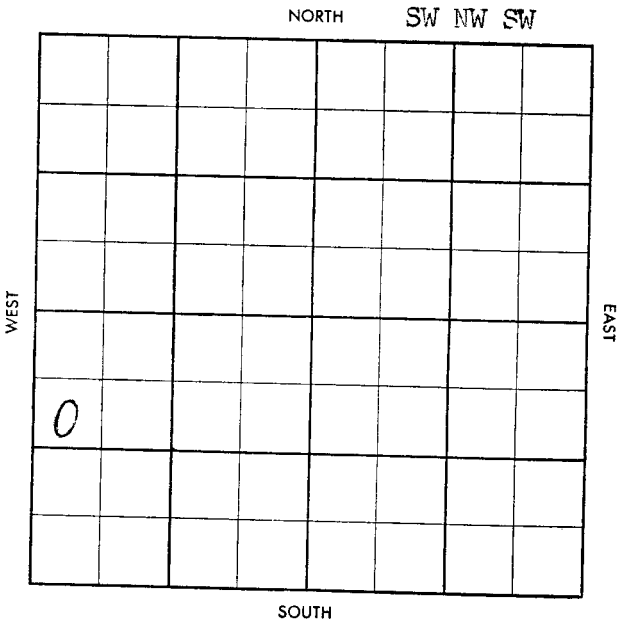

27

S-513-B

County Kingman Elev. _____
 Sec. 33 Twp. 29 Rge. 6W
 Company McKrab & Lindsay
 Farm Name Bell No. 5

TOPS	DEPTH	LOG	DATUM
Anh.			
Tp.			
H.			
Tr.			
Dg.			
B.L.			
L.			
K.C.			
B.K.C.			
Ce.			
C.			
M.			
M.			
K.			
Mz.			
Mq.			
V.			
S.			
S.			
A.			
R.			
Pf.			
G.			
T.D.			

Loc. in Sec. SW NW SW

Geol. _____
 Contr. Co. tools

Pool Rosedale

FIRST REPORT
 JAN 22 1958

Date Comm. 1-19-58
8" @ 190/125 drlg. 1250

Co. _____
 Loc. _____
 No. _____
 Sec. _____
 T. _____
 R. _____

Twp N Pool N
Co X Facet N

5-573-8

County Kingman Elev. 1482.00
Sec. 33 Twp. 29 Rge. 6W
Company McKnab & Lindsay
Farm Name Bell No. 5

TOPS	DEPTH	LOG	DATUM
Arth.			
Tp.			
Dr.			
Sp.			
Bl.			
L.	3259		
K.E.	3529		
B.K.C.			
Co.			
C.			
M.			
M.			
K.			
Mz.			
Mq.			
V.			
S.			
S.			
A.			
R.			
Pf.			
G.			
TD	3250		

Loc. in Sec. SW NW SW

Geol. _____
Contr. Co. tools

Pool Rosedale

MAR 19 1958
COMPLETE

Date Comm. 1-19-58

8" @ 190/125 dr. 1250

JAN 21 58

DST 3200-17 80" 830 gpm oil

BMP 770 PPS 55-240 55" 3749

FEB 5 '58 FEB 12 '58 FEB 19 '58 CD FEB 20 '58 12/3710

-12 50A 6 dry (1/2) FU 1000' Fld

15 BOPh + tr AW POP P95

B0 + tr AW 24 hrs WOPOTW 5 '58

MAR 12 '58 MAR 19 '58 Pp + P 163 POP 2 1/2

41' 9"