
KANSAS Grant County

FORM 51 5M 6-46 PETROL

Section 33 Township 29 Range 36-W

Well No. #2 White

Company United Prod.

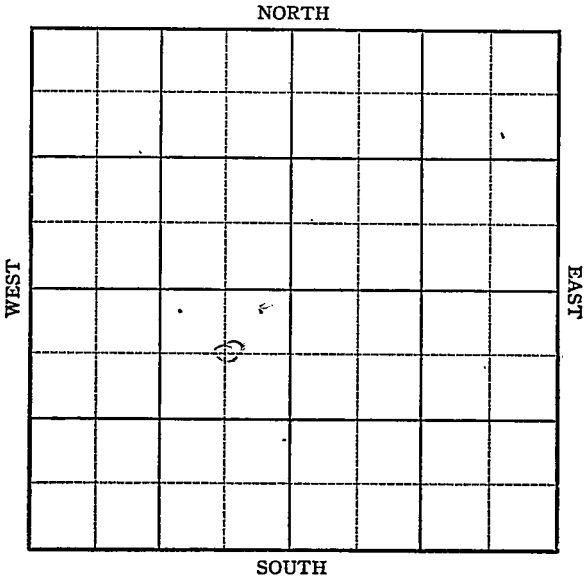

FORM 252-A
5M 6-46 PETROL

KANSAS Grant County ✓

Sec. 33 Twp. 29 R. 36W

Well No. #2 White Farm

United Prod. Company

Hugoton


100 Ft. from N. Line

Ft. from S. Line

100 Ft. from E. Line

Ft. from W. Line

NE SW

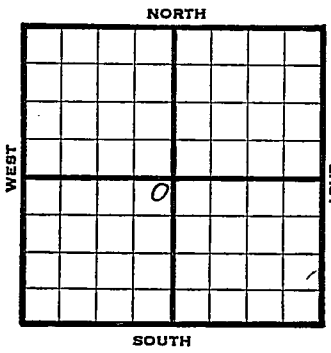

1946	3013 REPORT
8/21	Location
8/27	RUR
9/5	10" @ 633 1840 fsg
9/10	Drlg 2340'
9/18	TD 2480 Run 7"
9/24	7" @ 2476' RUST
10/1	Drlg 2540'
10/8	TD 2660' 190' of 5" Perf liner @ 2660'
10/15	" " "
10/22	12000 acid
10/29	" "
11/6	7" @ 2476' TD 2660' 190' of 5" Perf Liner @ 2660' 12,000 acid 21,538,000 Gas 424# RPR

COMPLETED

FORM 26 200 BKS. 2-44 PETROL

KANSAS Kansas Pool Name Hugoton

Map No. Sec. 33 Twp. 29 R. 36W

Well No. 2 White

United Prod. Company

FIRST REPORT Contractor

NE SW


100 Ft. from N. Line

Ft. from S. Line

100 Ft. from E. Line

Ft. from W. Line

SECTION PLAT

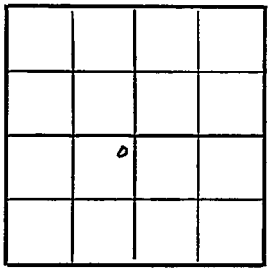

Grant County

Location X

Rig up

Drilling and Remarks:

RECORD

Cased in., ft.

Sand

Gas

Oil

Total Depth

PRODUCTION

1st 24 hrs. Nat.

1st 24 hrs. after shot

Gas Cu. Ft.

Dry Hole

Abandoned

Date

AUG 21 1946 19 S. J. LEWIS Scout

KANSAS

Hugoton Pool

Form 26 200 Bks. 10-46 Petrol Kansas

Map No. ____ Sec. 33 Twp. 29 R. 36W

Well No. 2 White

United Prod. Company

COMPLETED

Contractor

E1.3048

NE SW


SECTION PLAT

100 Ft. from N. Line

Ft. from S. Line

100 Ft. from E. Line

Ft. from W. Line

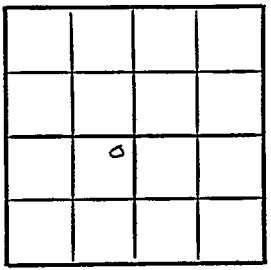

Grant County

Location

Rig up

Drilling and Remarks:

9" @ 476'

190' 5" Csg liner

@ 2660

12000 Acres

21,588,000 Gas

434* R Pe

RECORD

Cased ____ in., ____ ft.

Sand

Gas

Oil

Total Depth 2660

PRODUCTION

1st 24 hrs. Nat.

1st 24 hrs. after shot

Gas ____ Cu. Ft.

Dry Hole

Abandoned

Date

NOV 6 1946 19

S. J. LEWIS Scout