

Section 33 Township 29 Range 37 W


Well No. # 1 Hindmarsh

Company Hugoton Prod.

NORTH

WEST

EAST

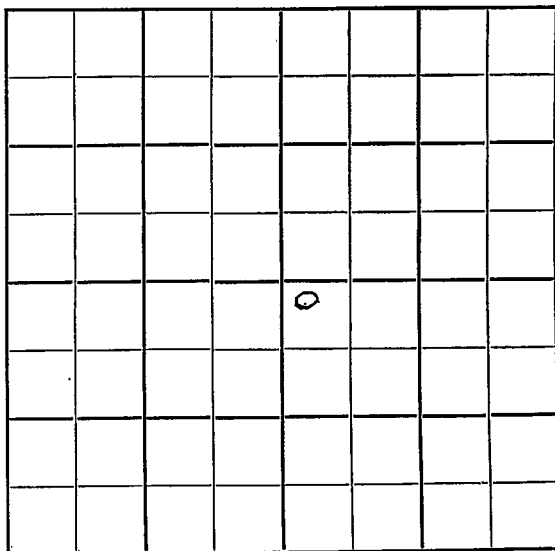

SOUTH

Sec. 33 Twp. 29 R. 37W

Well No. #1 Hindmarsh Farm

Hugoton Prod. Company

Contractor

Hugoton Pool


Ft. from N. Line

2440' Ft. from S. Line

2440' Ft. from E. Line

Ft. from W. Line

NW SE

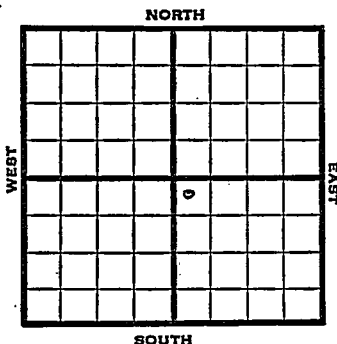

1951 Elev. 3080' REPORT

5/29 Location

8/22 Gas Well TD 2645

10" @ 568

7" @ 2390

TD 2645

Hol. 2359 Her. 2397

Krider 2418 Win. 2495

Ft. Riley 2558 17,000 A

Comp. 22,300,000 gas 434#

COMPLETED

