Kingman KANSAS

SECTION 33 TOWNSHIP 29S RANGE 8W

WELL NO. #1 C.L. Bertholf

COMPANY Pan American

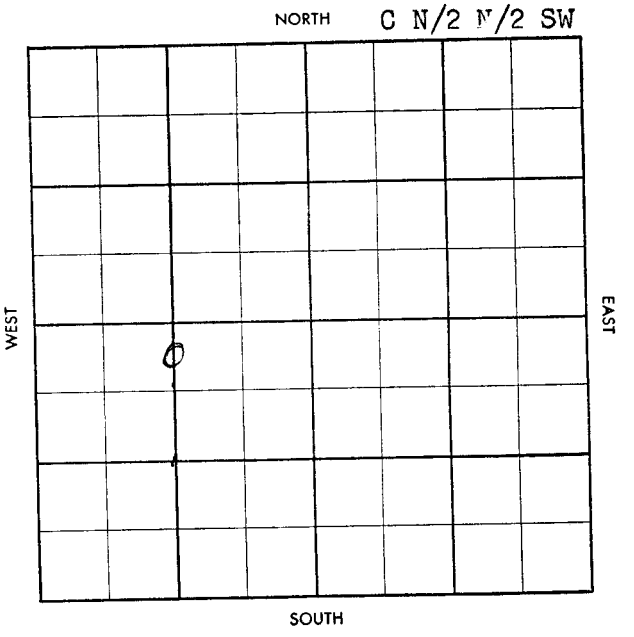

FORM 504-3 SUNRAY

Twp. X Pool X

Co. X Feet 47

5-513-B

County Kingman Elev.

Sec. 33 Twp. 29 Rge. 8W

Company Pan American

Farm Name C. L. Bertholf No. 1

TOPS	DEPTH	LOG	DATUM
Anh.			
Tp.			
H.			
Tr.			
Dg.			
B. L.			
L.			
K.C.			
B.K.C.			
Ce.			
C.			
M.			
M.			
K.			
Mz.			
Mq.			
V.			
S.			
S.			
A.			
R.			
Pf.			
G.			
T.D.			

Loc. in Sec. C N/2 N/2 SW 150' S N/2 N/2 SW/4

Geol.

Contr. ~~Barbour Drlg.~~

Pool Spivey Grabs

FIRST REPORT

JUN 25 '58

Date Comm. SW 1/4 mile

~~Location~~

Co. Lse. No. Sec. T. R.

Twp. X Pool X
Co. X Fasst X

County Kingman Elev 1621 or 1624 KB
33 Twp. 29 Rge. 8W
Pan American
Farm Name C. L. Bertholf No. 1

TOPS	DEPTH	LOG	DATUM
Ash.			
Tp.			
H.			
Tr.			
Dg.			
B.L.			
L.	3470	3474	
K.C.			
B.K.C.			
Ce.			
C.			
M.	4201	4205	-2577
M.			
K.			
Mz.			
Mq.			
V.			
S.			
S.			
A.			
R.			
Pf.			
G.			
T.D.	4320		

Loc. in Sec.
C N/2 N/2 SW
150' S N/2 N/2
SW/4

Geol.

Contr.
Barbour Drlg.

Pool
Spivey Grabs

1/4 mile
JUL 23 '58
COMPLETE

Date Comm. 6-27-58 8" 333/300
Location JUL 2 '58 Ø2125 JUL 9 '58 ØØ175
JUL 16 '58 DST 4195-4230 op 60"
g 1½" ga 5.590 mcf rec 60'M
BHP 1595 DST 4231-95 op 30"
ga 10.000 mcf rec 60'M BHP
1625 ram log 5½" 4320/250
MCT CO Ø285 JUL 23 '58 20/4210-14
30/4222-24 500A Flold ga 6.800
MCF 28/64" cht FCP100 FTP500
6,800 MCF ¢