


Section 33 Township 29 Range 33 W

Well No. # 1 ~~Preedy~~ Miller

Company Kuhn et al

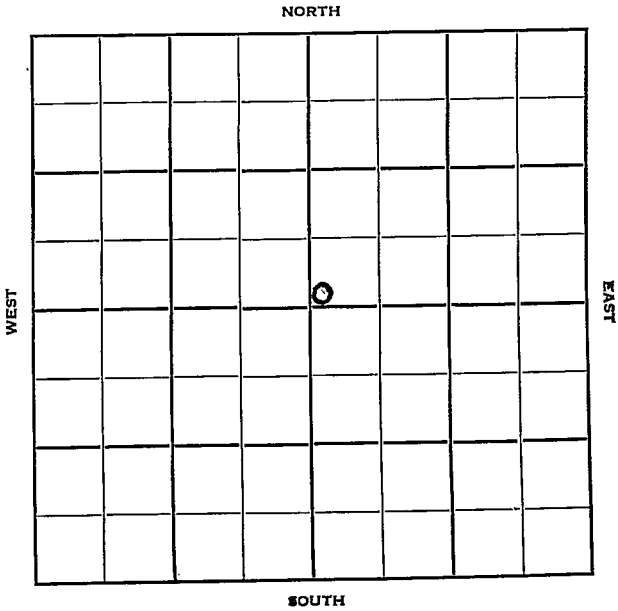

Sec. 33 Twp. 29 R. 33W

Well No. #1 ~~Preedy~~ <sup>Miller</sup> Farm

Kuhn et al Company

Hugoton Pool Contractor


         Ft. from N. Line

100 Ft. from S. Line

         Ft. from E. Line

100 Ft. from W. Line

SW NE

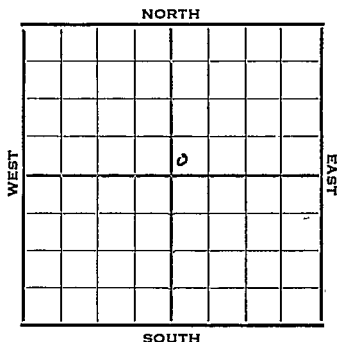

1952

REPORT

- 4/22 Location
- 4/30 "
- 5/7 "
- 5/14 10" @ 480'  
RTD 2645'  
7" @ 2639"
- 5/21 NR
- 5/28 "
- 6/11 "
- 6/18 Hol 2553' Her 2606' Krider 2633'
- 6/25 NR
- 7/2 MICT
- 7/9 Winfield 2713' DD 2710'  
3000 A TD 2745' 5000 A
- 7/17 NR
- 7/23 "
- 7/30 #
- 8/6 "
- 8/13 "
- 8/20 9000 A
- 8/27 "
- 9/3 NR
- 9/10 "
- 9/17 "
- 9/24 "

OVER

1952

10/1 Gas Well TD 2745  
10" @ 480' 7" @ 2639'  
Höl. 2553 Her. 2606  
Kri. 2633 Win. 2713  
TD 2710' 3000 A DD 2745  
17000 A Comp. 585,000 gas

**COMPLETED**



Scout Cards	.....
Land Small Map	.....
Land Wall Map	.....
Tracings	.....
France Map	.....
Pierce Map	.....
Misc	.....

*mw*

*3*

APR 25 1952

Orig. Data

Map No. \_\_\_\_\_ Sec. 33 Twp. 29 R. 33W

Well No. 1 Miller

Kuhn etal. Company

SW NE ~~CORRECTION~~ Contractor

SECTION PLAT

\_\_\_\_\_ Ft. from N. Line

100 Ft. from S. Line

\_\_\_\_\_ Ft. from E. Line

100 Ft. from W. Line

		D	

Haskell County

Location \_\_\_\_\_

Rig up \_\_\_\_\_

Drilling and Remarks:

Reported  
#1 Freedy

RECORD

Cased \_\_\_\_\_ in., \_\_\_\_\_ ft.

Sand \_\_\_\_\_

Gas \_\_\_\_\_

Oil \_\_\_\_\_

Total Depth \_\_\_\_\_

PRODUCTION

1st 24 hrs. Nat. \_\_\_\_\_

1st 24 hrs. after shot \_\_\_\_\_

Gas \_\_\_\_\_ Cu. Ft.

Dry Hole \_\_\_\_\_

Abandoned \_\_\_\_\_

Date

SEP 4 1952

J. G. McGEHEE

Scout Cards *mm*  
Land Small Map  
Land Wall Map  
Tracings  
France Map  
Pierce Map  
Misc.

SEP 8

1952



Scout Cards

Land Small Map

Land Wall Map

Tracings

France Map

Pierce Map

Misc.

1952  
1007

Orig. Data