


KANSAS

Pratt County

Section 34 Township 29 Range 14W

Well No. #1 Buck

Company Sinclair Prairie

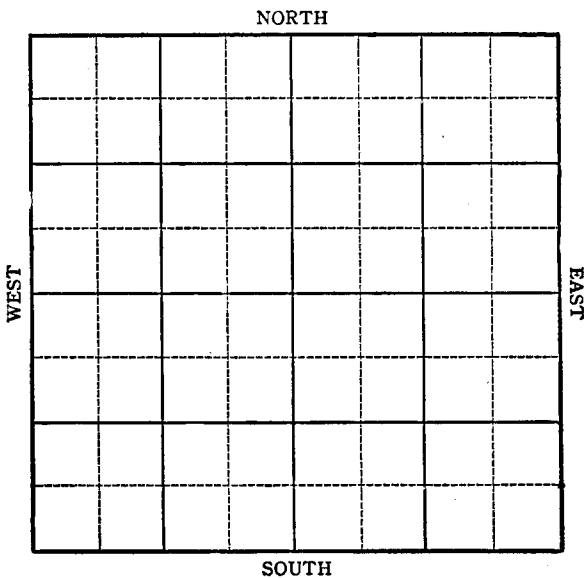

KANSAS

Pratt County

Sec. 34 Twp. 29 R. 14W

Well No. #1 Buck Farm

Sinclair Prairie Company


Shriver

330 Ft. from N. Line

\_\_\_\_\_ Ft. from S. Line

\_\_\_\_\_ Ft. from E. Line

990 Ft. from W. Line

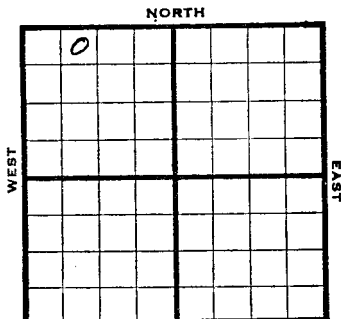

NE NW NW

R E P O R T

1944

11/1 Location

11/8 Drk.

1/16 8" @ 520' WOC

11/24 drlg. 3985

11/29 Lans 3990 Viola 3885 Simp 4511  
Simp Sd 4524  
TD 4550 r n csg.

12/6 5" @ 4524' RUST

2/14 " " " "

2/21 TD 4552'  
4000' fluid in 2 hrs.  
PB 4538' S.D.

12/29 Flow 8 oil PH 6 hrs.

1945  
1/3

1000 acid to shoot

1/10 15 qts 4530-35 CO

1/17 Flow 14 oil Ph 8 hrs

OVER

1945

L/24 Simp. Sd. 4524

5" 4524

PB 4538

15 qts 4530-4535

1000 acid.

TD 4552

Flow 192 in 8 hrs. Pot. 576

Grav. 36.9

**COMPLETED**

Pool Name Shriver

Map No. 92 Sec. 34 Twp. 29 R. 14W

Well No. 1 Duck

Sinclair Prairie Company

FIRST REPORT Contractor

NE NW NW


SECTION PLAT

330 Ft. from N. Line

\_\_\_\_\_ Ft. from S. Line

\_\_\_\_\_ Ft. from E. Line

990 Ft. from W. Line

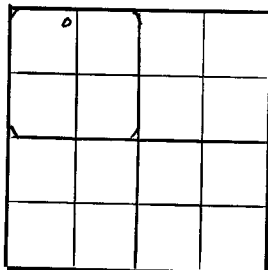

Pratt

Location X

Rig up \_\_\_\_\_

Drilling and Remarks:

RECORD

Cased \_\_\_\_\_ in., \_\_\_\_\_ ft.

Sand \_\_\_\_\_

Gas \_\_\_\_\_

Oil \_\_\_\_\_

Total Depth \_\_\_\_\_

PRODUCTION

1st 24 hrs. Nat. \_\_\_\_\_

1st 24 hrs. after shot \_\_\_\_\_

Gas \_\_\_\_\_ Cu. Ft.

Dry Hole \_\_\_\_\_

Abandoned \_\_\_\_\_

Date

NOV 1 1947 19

S. J. LEWIS Scout

Pool Name ShriverMap No. 15-95 Sec. 34 Twp. 29 R. 14WWell No. 1 BuckSinclair-Prairie CompanyCOMPLETED Contractor

NE NW NW

## SECTION PLAT

330 Ft. from N. Line

\_\_\_\_\_ Ft. from S. Line

\_\_\_\_\_ Ft. from E. Line

990 Ft. from W. Line

0			

Pratt

## RECORD

Location \_\_\_\_\_

Cased \_\_\_\_\_ in., \_\_\_\_\_ ft.

Rig up \_\_\_\_\_

Sand \_\_\_\_\_

Drilling and Remarks:

Gas \_\_\_\_\_

Bring Sol 4524

Oil \_\_\_\_\_

S 110 4524Total Depth 45-52PB 4538159 to 4530-351000 acidFlow 192 in 5 hrsPat 576

## PRODUCTION

1st 24 hrs. Nat. \_\_\_\_\_

1st 24 hrs. after shot \_\_\_\_\_

Gas \_\_\_\_\_ Cu. Ft.

Dry Hole \_\_\_\_\_

Abandoned \_\_\_\_\_

Date

36282

JAN 24 1945

19

S. J. LEWIS

Scout