

Kiowa


KANSAS

SECTION 31 TOWNSHIP 29 RANGE 16

WELL NO. #2 Betzer

COMPANY G-M-R Oil

NORTH

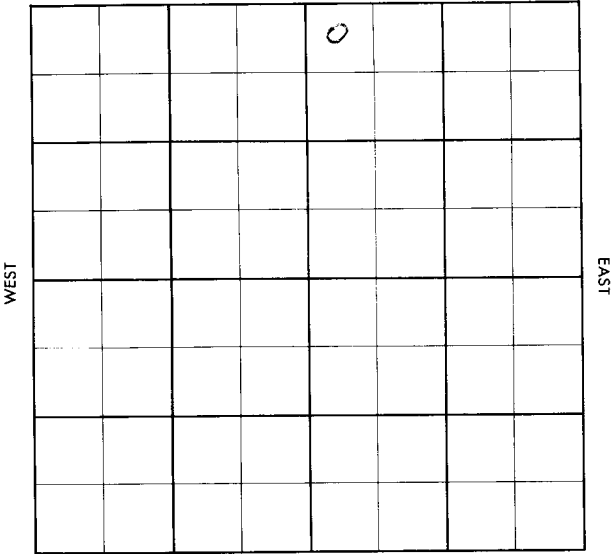

SOUTH

Kiowa

KANSAS


SEC.	TWP.	R.
34	29	16W

WELL NO. #2 Betzer FARM

COMPANY G-M-R Oil

CONTRACTOR Co. Tools
Betzer

_____ Ft. from N. Line
_____ Ft. from S. Line
_____ Ft. from E. Line
_____ Ft. from W. Line

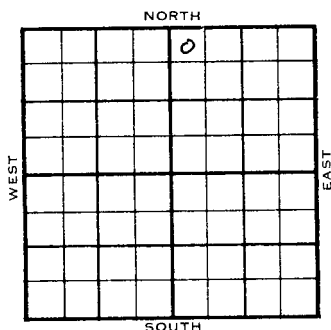

NW NW NE

1955	ELEVATION	REPORT
	1928'	
11/2	M I R	
11-30	Comm. 11-2-55 8 5/8" @ 255/175 DST 4634-76 op 1 hr. red. 25' mud, 0/20" DST 4833-51 op 1 hr. rec. 440' XXXX sul. wtr. 1450/20" D& A <u>Tops</u> <u>Log</u> H. 3873 Tr. 3890 Dg. 3926 BL. 4037 L. 4052 BKC 4178 Marm 4502 Ce 4570 Cong. 4592 Merrosive 4614 V. 4652 S. 4782 A 4958 TD 4985'	
		ABANDONED

County Kiowa Elev. _____
 Sec. 34 Twp. 29 Rge. 16W
 Company GAM-R Oil
 Farm Name Betzer No. 2

TOPS	DEPTH	LOG	DATUM	Loc. in Sec.
Anh.				NW NW NE
Tr.				
Dg.				
BL.				
L.				Geol. _____
K.C.				Contr. _____
B.K.C.				Co. tools _____
Ce.				Pool _____
C.				Betzer
M.				
M.				0 NOV 2 '51 FIRST REPORT
K.				
Mz.				
Me.				
V.				
S.				
S.				
A.				
R.				
Pe.				
G.				
T.D.				

Date Comm. M I R

25

NOV 7 1955

Scout Cards	mm
Land Small Map	
Land Wall Map	
Tracings	
France Map	
Pierce Map	
Misc.	

County Kiowa Elev. 1928
 Sec. 34 Twp. 29 Rge. 16W
 Company G-H-R Oil
 Farm Name Betzer No. 2

TOPS	DEPTH	LOG	DATUM	Loc. in Sec.
Anh.				NW NW NW
T.P.				
H.				
Tr.		3873	1945	
Dg.		3890	1962	
Bl.		3926	1998	
L.		4037	2109	
K.C.		4052	2124	Geol.
B.K.C.		4478	2550	Contr.
Ce.	mass	4512	2574	Co. tools
C.	ce	4520	2642	
M.	ce	4571	2664	
M.	mass	4614	2686	Pool
K.				Betzer
Mz.				
Mo.				
V.				
S.		4652	2724	
S.		4732	2854	
A.				
R.		4752	2881	
Pe.				
G.				
ED.	4755			

ABANDONED

Date Comm. 11-2-55

NOV 3 0 1955

8 5/8" @ 255/175 D-T 4634-76 open

1 hr. rec. 25' mud @ 20" D-T 4833-51

open 1 hr. rec. 140' sul. wtr. 1430/20"

D & A