Kingman

KANSAS

SECTION 34 TOWNSHIP 29S RANGE 9W

WELL NO. #1 Bohrer "F"

COMPANY Petroleum Inc.

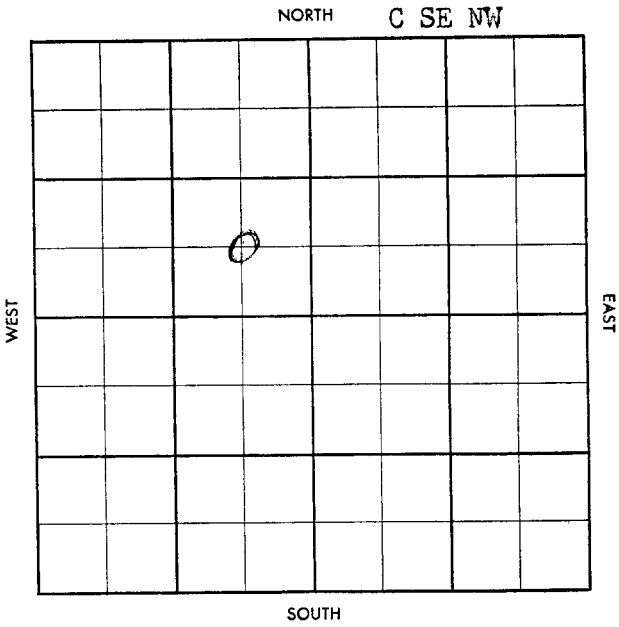

FORM 504-3 SUNRAY

S-513-B

County Kingman Elev.

Sec. 34 Twp. 29 Rge. 9W

Company Petroleum Inc.

Farm Name Bohrer "F" No. 1

TOPS	DEPTH	LOG	DATUM
Anh.			
Tp.			
H.			
Tr.			
Dg.			
B.L.			
L.			
K.C.			
B.K.C.			
Ce.			
C.			
M.			
M.			
K.			
Mz.			
Mq.			
V.			
S.			
S.			
A.			
R.			
Pf.			
G.			
T.D.			

Loc. in Sec. C SE NW

Geol.

Contr. Garvey #5

Pool Spivey-Grabs



Date Comm. 4/9/58 Mag. = FO.

8" @ 278 w/175, Drlg. 3752

Twp. X Pool X

Co. X Feet X

S-513-B

County Kingman Elev 1617 DF 1627 RB

Sec. 34 Twp. 29 Rge. 9W

Company Petroleum Inc.

Farm Name Bohrer "F" No. 1

TOPS	DEPTH	LOG	DATUM
Anh.			
Tp.			
H.	3314		
Tr.	3329		
Dg.	3347		
B.L.			
L.	3538		
K.C.			
B.K.C.	3994		
Ce.			
C.			
M.	4208		
M.			
K.			
Mz.			
Mq.			
V.			
S.			
S.			
A.			
R.			
Pf.			
G.			
T.D.	4308		

Loc. in Sec. C SE NW

Geol.

Contr. Garvey #5

Pool Spivey-Grabs

APR 23 '58

ABANDONED

Date Comm. 4/9/58 Mag. - FO.

8" @ 278 w/175, Drlg. 3752 APR 23 '58 DST

4209-20 1hr 30'M BHP 760/20

DST 4214-4308 1hr 30'M FP

100-100 BHP 100/20" no log

DOA

Co. Lse. No. Sec. T. R.