
Kingman KANSAS

DX 78-1

Section 34 Township 29 Range 9W

Well No. #1 Kibbe

Company Petroleum Inc.

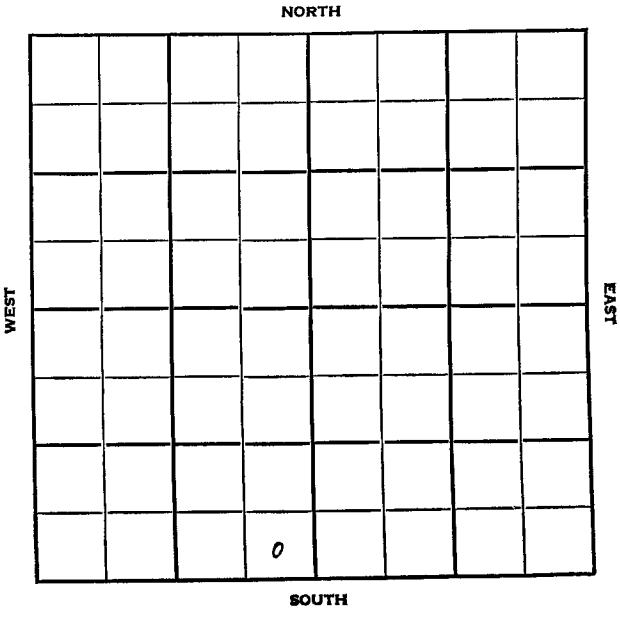

Kingman KANSAS

SEC.	TWP.	R.
34	29	9W

WELL NO. 1 Kibbe FARM

COMPANY Petroleum, Inc.

CONTRACTOR Todd


Wildcat

_____ Ft. from N. Line

330 Ft. from S. Line

330 Ft. from E. Line

_____ Ft. from W. Line

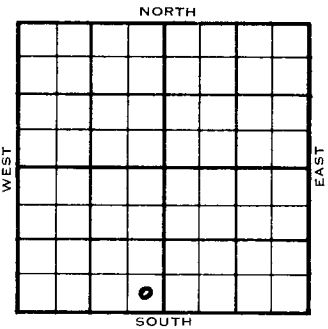

SE SE SW
Lion FO

1955	ELEVATION	REPORT
3/2		Spud 2-28-55 8" @ 262', WOC

DX-78

FORM 275 FOR SALE BY KANSAS BLUE PRINT CO.


County Kingman State Kansas

Sec. 34 (Blk. Twp.) 29 (Sur. Rge.) 9W Map No.

Operator Petroleum Inc.

Well No. 1 Farm Kibbe

Elev. Location SE SE SW

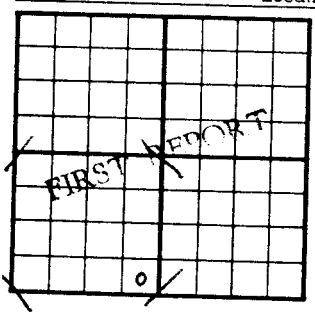

330 Ft. From S Line SW

330 Ft. From E Line Quarter

1st. Report MAR 2 1955

Completion

Remarks Lion farmout
Todd - Contr.

Spudding Date 2-28-55

Drlg. Data Wildcat

8" @ 262 WOC

FABEN GILSTRAP