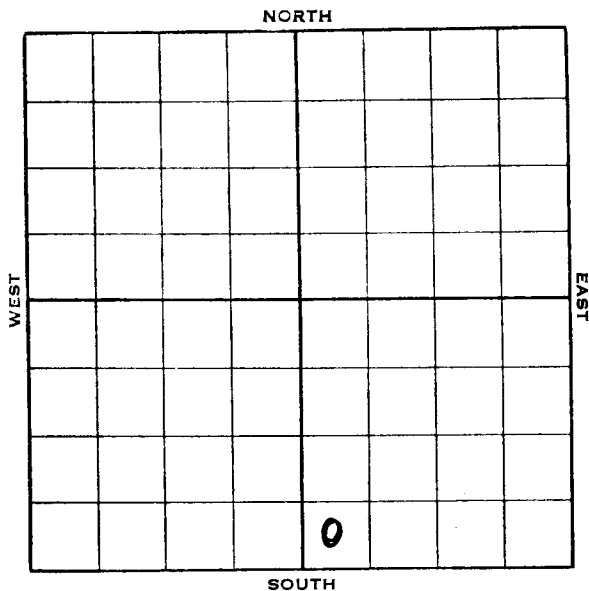


Sedgwick

KANSAS

Section 34 Township 29 Range 1-WWell No. 1 MurphyCompany Crowe et al

KANSAS


Sedgwick

Sec. 34 Twp. 29 R. 1-WWell No. #1 Murphy FarmCrowe et al Company

Ft. from N. Line

330 Ft. from S. Line

Ft. from E. Line

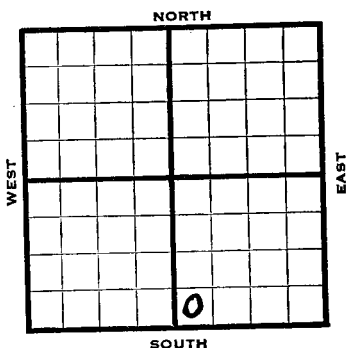330 Ft. from W. Line

Elev. 1253

REPORT

1938

5/18 Rig.

5/27 "

6/3 "

6/10 "

6/17 "

6/24 "

7/1 Rig

7/8 "

7/15 "

7/22 "

7/29 "

8/5 "

8/12 "

8/19 "

8/26 "

9/2 "

9/9 Rig'n. up.

9/16 15" - 110'. Dlg. 295'.

9/23 T. D. 993'. Rng. 12".

9/30 12" - 996'. T. D. 1725'.

Rng. 10".

.938

.0/7 10" - 1725'. 8" - 2137'.
Drlg. 2257'.

.0/14 8" - 2365'. Stalnaker 2520'.
Dlg. 2570'.

.0/21 K. C. 2845'. Dlg. 2900'.

.0/28 H.F.W. 2935'. 8" - 2960'.
Dlg. 3330'.

.1/4 7" - 3390'. Miss. 3420'.
Dlg. 3435'.

11/12 2 B. W. 3500'. Drlg. 3695'.

11/16 7" - 3390'.
Arb. 3920'.
T. D. 3925'.
H. F. W.

Sedgwick KANSAS

Map No. 38 Sec. 34 Twp. 29 R. 1WWell No. 1 MurphyCrowe et al

Company

Contractor

FIRST REPORT

SW SE

 Ft. from N. Line330 Ft. from S. Line Ft. from E. Line330 Ft. from W. Line

SECTION PLAT

Location

RECORD

Cased in., ft.Sand Gas Oil Total Depth

PRODUCTION

1st 24 hrs. Nat. 1st 24 hrs. after shot Gas Cu. Ft.Dry Hole Abandoned

Drilling and Remarks:

RIG

Date

MAY 18 1938

19

H. D. Hatfield Scout

Sedgwick

KANSAS

Map No. 38 Sec. 34 Twp. 29 R. 1WWell No. 1 MurphyCrowe Etal Company

Contractor

ABANDONED

SW SE

Ft. from N. Line

330 Ft. from S. Line

Ft. from E. Line

330 Ft. from W. Line

SECTION PLAT

		0	

Location _____

Rig up _____

Drilling and Remarks:

HFW

D & A

RECORD

Cased 7 in., 5390 ft.Sand Arb 3920

Gas _____

Oil _____

Total Depth 3925

PRODUCTION

1st 24 hrs. Nat. _____

1st 24 hrs. after shot _____

Gas _____ Cu. Ft.

Dry Hole _____

Abandoned _____

Date

NOV 16 1938 19 H. D. Hatfield Scout