


Kingman

KANSAS

SECTION 34 TOWNSHIP 29S RANGE 7W
WELL NO. #3 Hankins *(Hankins)*
COMPANY O.A. Sutton

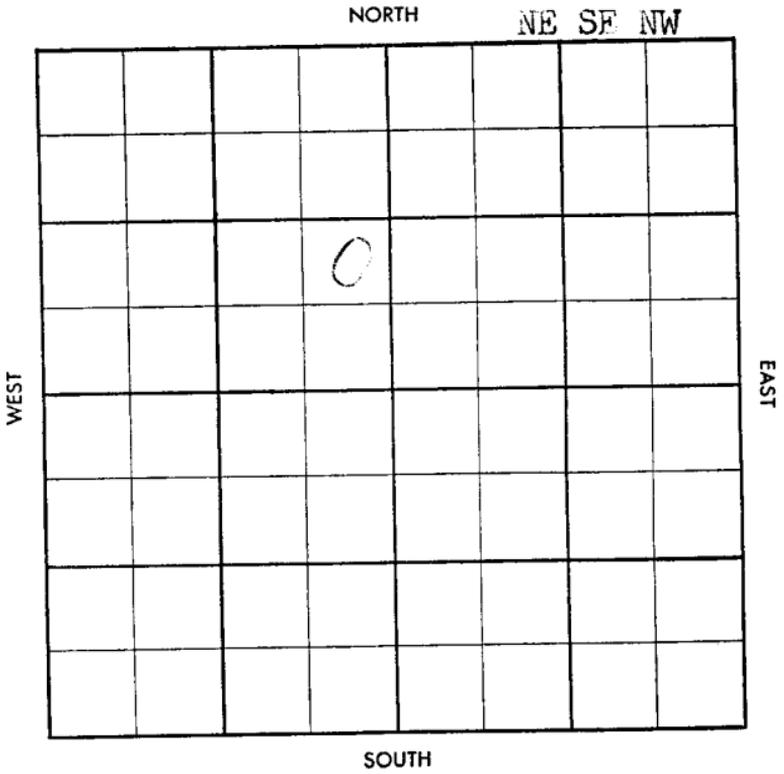

~~Gilchrist~~

~~2A~~

FORM 513 SUNRAY

County ~~Kingman~~

Elev.

Sec. ~~34~~

Tr. ~~29~~

Rge. ~~7W~~

Company ~~O. A. Sutton~~

Farm Name ~~Hankins~~

No. ~~3~~

| TOPS | DEPTH | LOG | DATUM |
|--------|-------|-----|-------|
| Anh. | | | |
| Tp. | | | |
| H. | | | |
| Tr. | | | |
| Dg. | | | |
| Bl. | | | |
| L. | | | |
| K.C. | | | |
| B.K.C. | | | |
| Ce. | | | |
| C. | | | |
| M. | | | |
| M. | | | |
| K. | | | |
| Mz. | | | |
| Mo. | | | |
| V. | | | |
| S. | | | |
| S. | | | |
| A. | | | |
| R. | | | |
| PE. | | | |
| G. | | | |
| TD. | | | |

Loc. in Sec.

~~NE SE NW~~

Geol.

Contr.

~~Gabbert-Jones~~

Pool

~~Trenton~~
~~FIRST REPORT~~

~~SEP 18 57~~

Date Comm. ~~9-13-57~~

~~8" @ 253/225 drlg. 1800~~

Co.

Loc.

No.

Sec.

T.

R.

ENAC 10X10 - rec Ld Flb

125 B fld 50% W Flb

8 BO + 27 BW ph NT

ga 1.00 mcf RB 4160

12/ 4134 - 38 55g 15 gwph

sl 30 hrs \$ 1 BW ph \$

4134 - 38 OC 23 57 16/3322 - 52

Frac OC 30 57 10X10 input

126 BW ph ~~2~~ 3 hrs CO TO

4208 TD ~~1~~ (4150' prod PK)

\$ 39 WPH \$ cum oil

NOV 13 57 \$ 12 1/2 BO + 37 1/2 BW bhu

\$ 2 1/2 BO PH + 5 BW ph 8 hrs

NOV 13 57 NOV 20 57 P 28 BO nt

Broke Down NOV 27 57 back on P

P 33 BO + 100 BW 24 hrs

DEC 4 57 DEC 11 57

Start ^{test} 37 BO pd + 75% W

33% W

SW in KC