Kingman KANSAS

SECTION 34 TOWNSHIP 29 RANGE 7W

WELL NO. #1 Hankins (Hankins)

COMPANY O.A. Sutton

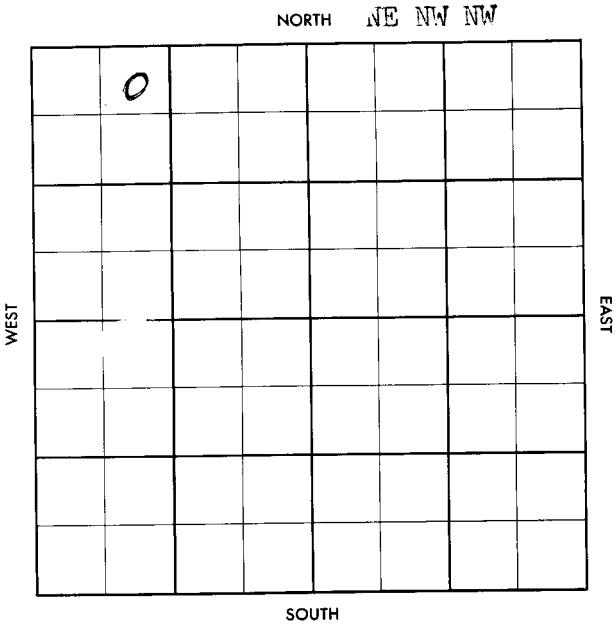

FORM 504-3 SUNRAY

ORM 513 SUNRAY

County Kingman Elev.

Sec. 34 Twp. 29 Rge. 7W

Company O. A. Sutton

Farm Name Hankins No. 1

TOPS	DEPTH	LOG	DATUM
Anh.			
Tp.			
H.			
Tr.			
Dg.			
Bl.			
L.			
K.C.			
B.K.C.			
Ce.			
C.			
M.			
M.			
K.			
Mz.			
Mo.			
V.			
S.			
S.			
A			
R.			
P€.			
G.			
TD.			

Loc. in Sec. NE NW NW

Geol.

Contr. Gabbert-Jones

Lse. GILCHRIST

Voran

MAR 27 '57

FIRST REPORT

Date Comm. 3-20-57

8" @ 215/200, Drlg. 2930

Co. Sec. T. R.

FORM 513 SUNRAY

County Kingman Elev. 1513

Sec. 34 Twp. 29 Rge. 7W

Company C. A. Sutton

Farm Name Hankins No. 1

TOPS	DEPTH	LOG	DATUM
Anh.			
Tp.			
H.			
Tr.			
Dg.			
B.L.			
L.			
K.C.	3331		
B.K.C.			
Ce.			
C.			
M.	4128		
M.			
K.			
Mz.			
Mo.			
V.			
S.			
S.			
A			
R.			
P€.			
G.			
T.D.	4144		

Loc. in Sec. NE NW NW

Geol.

Contr. Gabbert-Jones

Pool Voran

JUL 3 '57

COMPLETE

Date Comm. ~~3-20-57~~

8" @ 215/200, Drlg. 2930 TD 4144

APR 10 '57 X DST 4130-44 op 90"

G/6" ga 295 MCF/10" ga 228

MCF end of TST rec 55' GCM

BHP 962 RTD 4144 5½ @

4134 WOCT RUCT APR 24 '57

CO DD 4190 TD B & Gopht

2 GWPH FU 750' Fluid in

55 hrs (15 30 + 4 BW) ~~[illegible]~~

Co. Lse. No. Sec. T. R.

FORM 513-1 SUNRAY

DD 4225 B 13 Goph +
2 GW in 1hr B 14 Goph
+ 3 GW in 1hr FU 620'
oil + 150' wtr 55 hrs PB
4203 PBTD Frac 5 x 5
[illegible] Ld PSP [illegible]
[illegible]
Ph P. 41 Bopd + 38%
wtr grav 35°