


Kingman

KANSAS

SECTION 34 TOWNSHIP 29 RANGE 7W

WELL NO. #2 Hankins *(Hankins)*

COMPANY O.A. Sutton

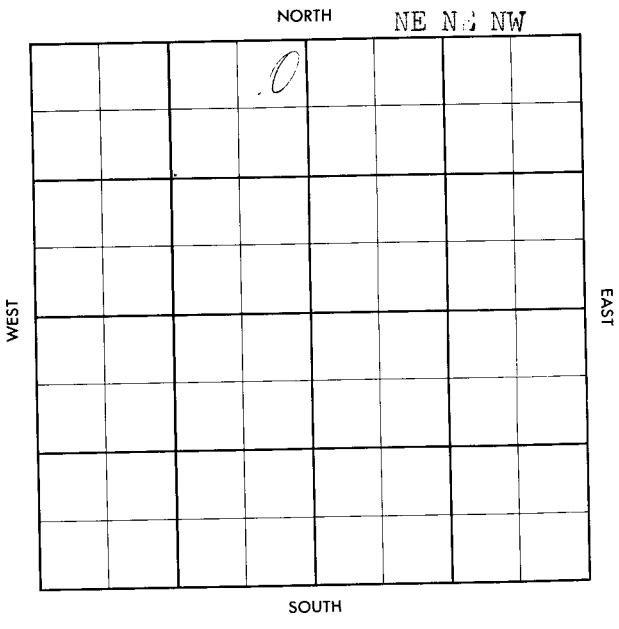

Kingman

SEC.

TWP.

R.

34

29 S

7 W

WELL NO.

2 Hankins

FARM

COMPANY

O. A. Sutton

CONTRACTOR

Gabbert-Jones

Vorán

____ FT. FROM N. LINE


____ FT. FROM S. LINE

____ FT. FROM E. LINE

____ FT. FROM W. LINE

NE NE NW

SDX-1/4 Mile

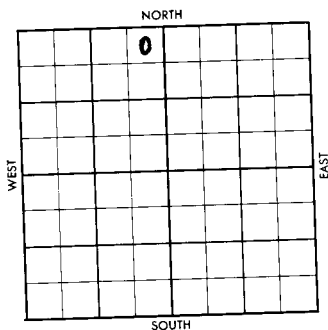

ELEVATION

REPORT

1957

5/8

Comm. 5-1-57

8" @ 263/225

Drlg. 2790'

(SR Pkt)

ORM 513 SUNRAY

County Kingman Elev. _____
 Sec. 34 Twp. 29 Rge. 7N
 Company O. A. Sutton
 Farm Name Hankins No. 2

TOPS	DEPTH	LOG	DATUM	Loc. in Sec.
Anh.				NE NE NW
Tr.				
H.				
Tr.				
Dg.				
Bl.				
L.				
K.C.				
B.K.C.				
Ce.				
C.				
M.				
M.				
K.				
Mz.				
Mo.				
V.				
S.				
S.				
A.				
R.				
Pe.				
G.				
SD				

Geol. _____
 Land _____
 Gabbert-Jones
 Pool GIACRIST
 Voran
 MAY 8 57
 FIRST REPORT
 SDX 4 mile

Date Comm. 5-1-57

8" @ 263/225, Drlg. 2790

~~27~~

County Kingman Elev. 1507
 Sec. 34 Twp. 29 Rge. 7W
 Company C. A. Sutton
 Farm Name Harkins No. 2

	DEPTH	LOG	DATUM	Loc. in Sec.
				NE NE NW
W.				
Tr.				
Dg.	<u>3216</u>			
Bl.				
L.				
K.C.	<u>3330</u>			Geol.
B.K.C.	<u>3816</u>			Contr. <u>Gibbist</u>
Ce.				<u>Gabbert-Jones</u>
C.				Prod. <u>172488</u>
M.	<u>4108</u>			Voran
M.				
K.				
Mz.				
Me.				
V.				
S.				
S.				
A.				
R.				
Pe.				
G.				
TD	<u>4160</u>			

0
JUN 21 57
COMPLETE
1/4 mile

Date Comm. 5-1-57

8" 263/225, Drlg. 2790 MAY 15 57 5 1/2
 4159 MAY 22 57 ✓ MAY 29 57 DP 4193
 TP 100 Acid B 1/2 GFPH
 FRAC 5 x 5 Flwd 26 BFPH
 60% oil + est 9a 5 Mill.
 CFG JUN 5 57 4183 FRAC
 5 x 5 S.I. 12 hrs JUN 12 57
 Flwd 330 BF (60% oil) 6 hrs
 + 9a 2 Mill CFGPd. JUN 19 57 JUN 26 57

FORM 513-1 SUNRAY

MS: 457 AUG 21 57 Phy P₀ 240+227, 6234.5
Miss QH 2 59-83