Kingman KANSAS

SECTION 34 TOWNSHIP 29 RANGE 7W

WELL NO. #1 Ruth Holder

COMPANY Skelly Oil

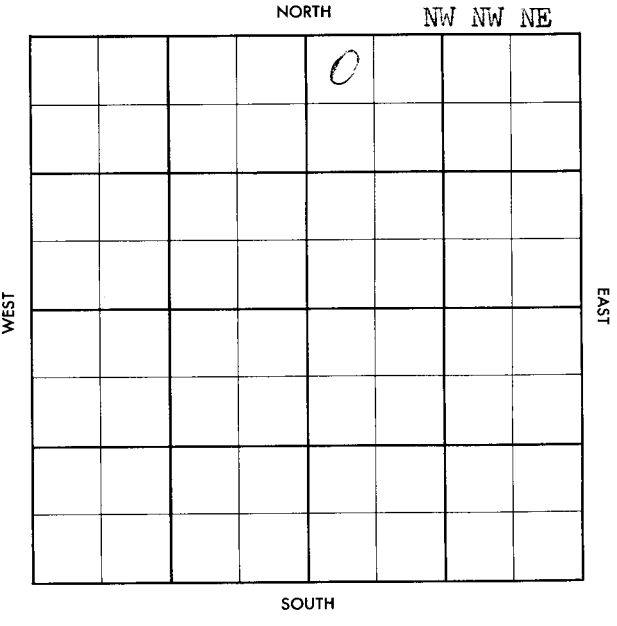

FORM 504-3 SUNRAY

Kingman

SEC.	TWP.	R.
34	29 S	7 W

WELL NO.

1 Ruth Holder FARM

COMPANY

Skelly Oil

CONTRACTOR

Wentworth
Trenton

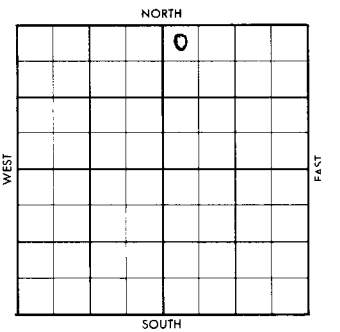

_____ FT. FROM N. LINE

_____ FT. FROM S. LINE

_____ FT. FROM E. LINE

_____ FT. FROM W. LINE

NW NW NE

SDX-1/4 Mile

ELEVATION	REPORT
1957	
9/11	Location (FR Tkt)

FORM 504-5 SUNRAY

Gilchrist

ORM 513 SUNRAY

County Kingman Elev.

Sec. 34 Twp. 29 Rge. 7W

Company Skelly Oil

Farm Name Ruth Holder No. 1

TOPS	DEPTH	LOG	DATUM
Anh.			
Tp.			
H.			
Tr.			
Dg.			
Bl.			
L.			
K.C.			
B.K.C.			
Ce.			
C.			
M.			
M.			
K.			
Mz.			
Mo.			
V.			
S.			
S.			
A			
R.			
P€.			
G.			
TD			

Loc. in Sec. NW NW NE

Geol.

Contr. Wentworth

Pool Trenton



SDX-¼ MILE

Date Comm.

Location

Co. Lse. No. Sec. T. R.

FORM 513 SUNRAY

County Kingman Elev.

Sec. 34 Twp. 29 Rge. 7W

Company Skelly Oil

Farm Name Ruth Holder No. 1

TOPS	DEPTH	LOG	DATUM
Anh.			
Tp.			
H.			
Tr.			
Dg.			
Bl.			
L.	3317		
K.C.			
B.K.C.			
Ce.			
C.			
M. Li	4121		
M.			
K.			
Mz.			
Mo.			
V.			
S.			
S.			
A			
R.			
PE.			
G.			
TD	4160		

Loc. in Sec. NW NW NE

Geol.

County Wentworth

Pool Trenton

COMPLETE

NOV 18 '57

¼ MILE

Date Comm.

Location SEP 18 57 9-12-57 6" 328/125

ID 1050 SEP 25 57 ID 3570 OCT 2

DST 4123-42 1hr G/35" TSTM

30' GCDM FP 47-47 BHP

1144/20" DST 4142-60

75" 2000 GIP 60' 500 GCM

34-37 BHP 961/20

5" 4123/15-0 OCT 9 57

CO 4160 2g MOPH NT

813-1 SUNRAY

23 57 CODD 4167 TD
B 7g mo ph 6 hrs
frac rec Flo
133 BO + 1½ BW 22/64 chk
7 hrs ga 139 mcp FTP 340
ECP 880' OCT 30 57 Flo 227
BO + 2½ BW 22/64" chk
24 hrs pop OCT 6 57 Flo 91 BO
+ 47 BW 16 hrs 18/64" chk
FTP 420 FCP 820 NOV 13 57

Pot Flo 170 BO + 34% ow
34° gr

miss 4123-67

34-29-7W

mw mw mw