


Kingman

KANSAS

SECTION 34 TOWNSHIP 29 RANGE 8W

WELL NO. #1 McCoy

COMPANY Aylward Drlg.

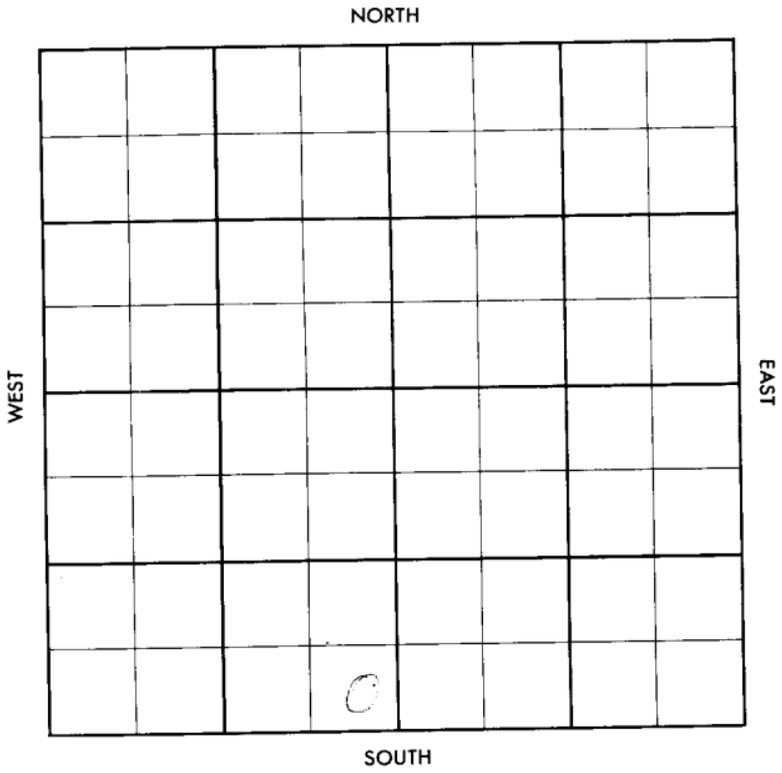

County **Kingman** Elev. _____
 Sec. **34** Twp. **29** Rge. **8W**
 Company **Aylward Drlg.**
 Farm Name **McCoy** No. **1**

TOPS	DEPTH	LOG	DATUM	Loc. in Sec.												
Anh.				SESESW												
Tp.																
H.																
Tr.																
Dg.																
Bl.																
L.				Geol. _____												
K.C.				Contr. _____												
B.K.C.				Co. tools _____												
Ce.																
C.				Pool _____												
M.				Spivey-Grabs												
M.				<table border="1"> <tr> <td></td> <td></td> <td></td> </tr> <tr> <td colspan="3">FIRST REPORT</td> </tr> <tr> <td></td> <td>JAN 3 '57</td> <td></td> </tr> <tr> <td></td> <td></td> <td></td> </tr> </table>				FIRST REPORT				JAN 3 '57				
FIRST REPORT																
	JAN 3 '57															
K.																
Mz.																
Me.																
V.																
S.																
S.																
A.																
R.																
PE.																
G.																
TD.																

Date Comm. **12-27-56** Gulf @ **70**
8W @ 197/50 drlg. **3300**

~~27~~

Co.
L.S.
No.
Sec.
T.
R.

County Kingman Elev. 1530
 Sec. 34 Twp. 29 Rge. 8W
 Company Aylward Drlg.
 Farm Name McCoy No. 1

TOPS	DEPTH	LOG	DATUM	Loc. in Sec.
Anh.				SE SE SW
Tr.				
H.				
Tr.				
Dg.	3200			
Bl.				
L.	3289			
K.C.				Geol.
B.K.C.	3886			Contr.
Ce.				Co. tools
C.				
M. <u>Chert</u>	4125			Pool
M.				Spivey-Grabs
K.				
Mz.				
Me.				
V.				
S.				
S.				
A.				
R.				
PE.				
G.				
TD	4241			

COMPLETE
 MAR 27 57

Date Comm. 12-27-56 Gulf - FO
 8" @ 197/50 drlg. 3300

DST 4128-54 1hr G/3"
9a. 780 MCFG rec 132' GCM
FR 110-113 BHP 1600/20"
DST 4157-89 ex. 9a 3,500
MCFG in 2 hrs rec 113' W6CM
E SW FR 417-437 BHP 1594/20
Rn9 4 1/2" WGET 4 1/2"
4241 WGET MAR 27 57 MICT

PF 119/4152-80 FRAC FEB 18 57

7a est 6 MILL CFG FEB 13 57

MAR 27 57

MAR 27 57

comp 6 MILL CFG PD

S. H. Gas well