STUART 3-34R T.1S R.3S W Sec.34

MARTY'S ENVIRONMENTS

PCP – Paleosol/Coastal Plain
TF – Tidal Flat
L – Lagoon
S – Shoal
SPAB – Phylloid Algae Bk
CDS – Carbonate Dominated Shr-F
SDS – Siliciclastic Dom. Shr-F
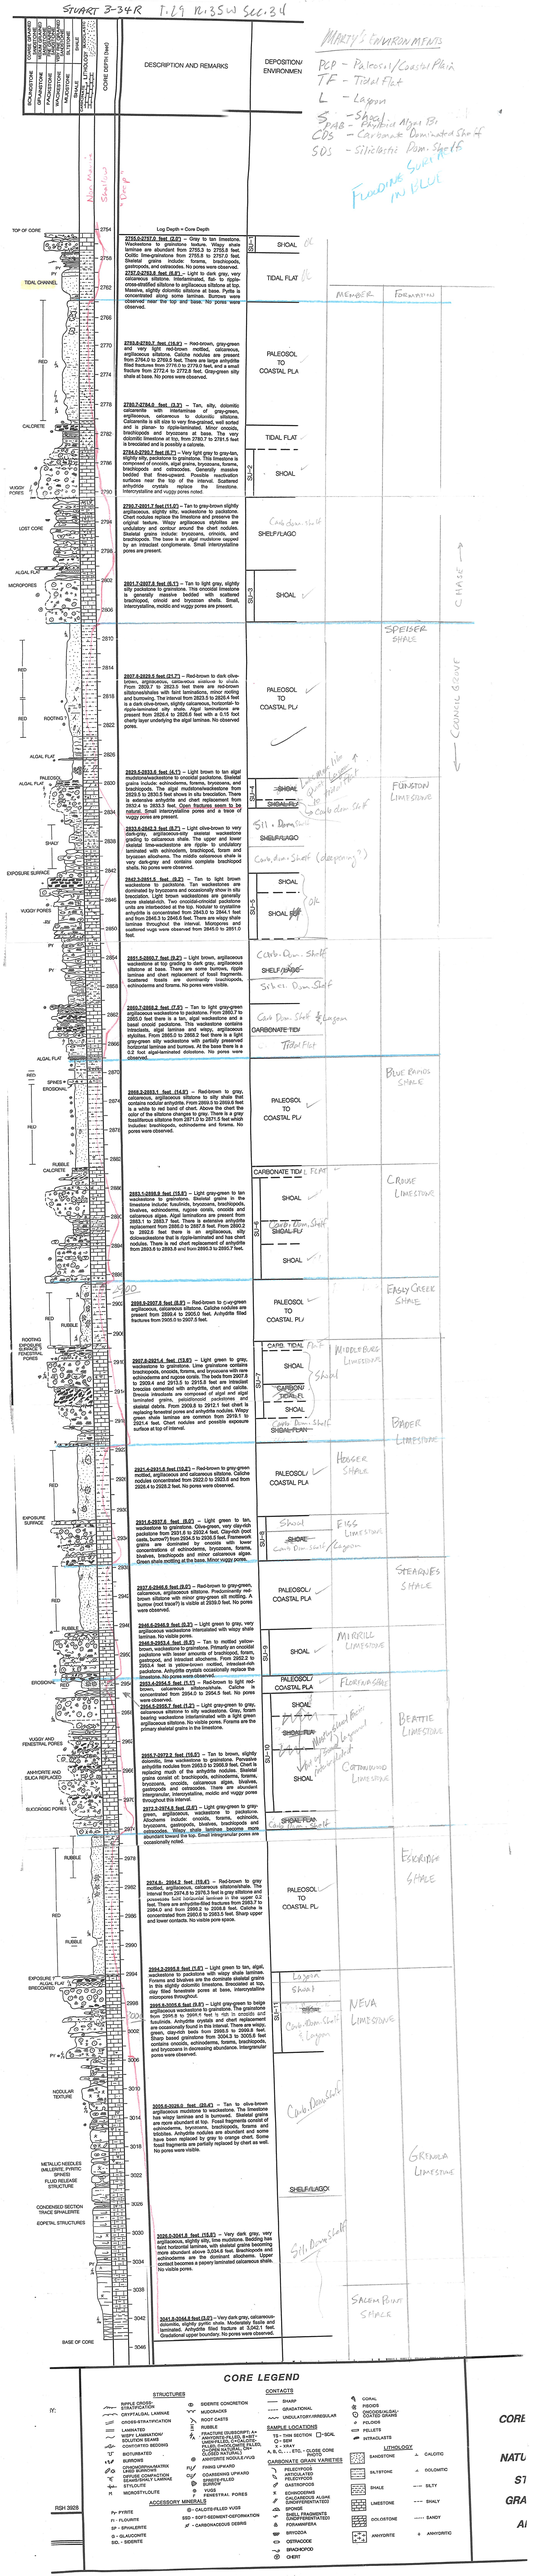
FLOODING SURFACE IN VELL