


Section 35 Township 29 Range 1/W

Well No. 1 Shriver

Company Cities Service

Clara Pool

NORTH

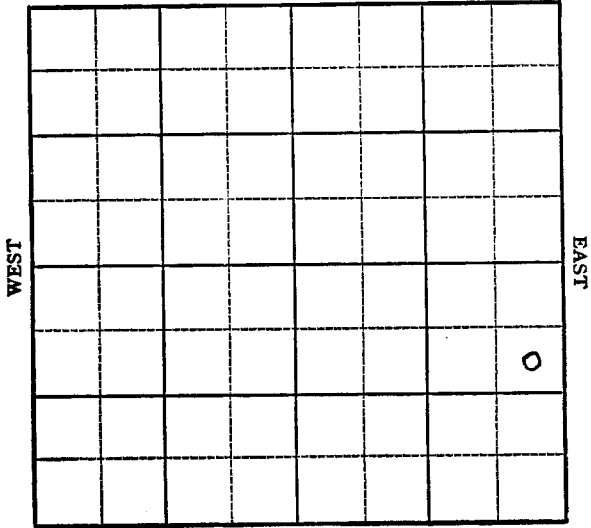

SOUTH



Sec. 35 Twp. 29 R. 14W

Well No. 1 Shriver Farm

Cities Service Company  
Clara Pool


990 Ft. from N. Line

\_\_\_\_\_ Ft. from S. Line

330 Ft. from E. Line

\_\_\_\_\_ Ft. from W. Line

SE NE SE

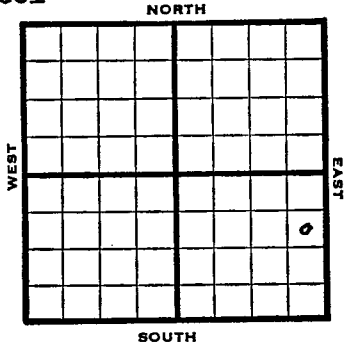

1948	Eli 1967'	REPORT
11/17	Location	
11/23	8" @ 402'	
11/30	Drlg. 4005'	
12/6	Lansing 3959'	
	Viola 4439'	
	Simpson 4485'	
	Arbuckle 4563'	
	TD 4565'	
	5" @ 4565'	
12/14	SIM 4565-60'	
	Lansing 3954'	
	Viola 4434'	
	Simp. 4480'	
	Simpson Sd 4487'	
	Arbuckle 4568'	
	TD 4552 wtr	
	PB	
12/22	Plug 4550'	
	59 shots 4488-4518	
	57- " 4483-96	
	20 " 4487-87	
12/29	Flow 123 bbls oil - 10 hrs.	
	TD 4562'	
	Viola 4434'	
	Simpson Sd 4487'	
	Arb 4558'	
	5" @ 4560'	
	Perf Simp	
	Flow 315 oil Pot	
	44 <sup>0</sup> Gr.	
	Comp	
	<b>COMPLETED</b>	

Map No. \_\_\_\_\_ Sec. 35 Twp. 29 R. 14W

Well No. 1 Shriver

\_\_\_\_\_ Cities Service \_\_\_\_\_ Company

**FIRST REPORT** \_\_\_\_\_ Contractor

SE NW SE


**SECTION PLAT**

990 Ft. from N. Line

\_\_\_\_\_ Ft. from S. Line

330 Ft. from E. Line

\_\_\_\_\_ Ft. from W. Line

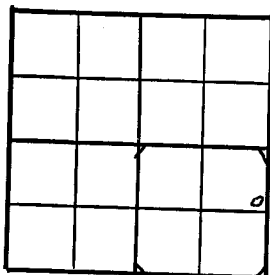

Pratt County

Location X

Rig up \_\_\_\_\_

Drilling and Remarks:

**RECORD**

Cased \_\_\_\_\_ in., \_\_\_\_\_ ft.

Sand \_\_\_\_\_

Gas \_\_\_\_\_

Oil \_\_\_\_\_

Total Depth \_\_\_\_\_

**PRODUCTION**

1st 24 hrs. Nat. \_\_\_\_\_

1st 24 hrs. after shot \_\_\_\_\_

Gas \_\_\_\_\_ Cu. Ft.

Dry Hole \_\_\_\_\_

Abandoned \_\_\_\_\_

Date

NOV 17 1948 19

S. J. LEWIS Scout

Map No. 22 Sec. 35 Twp. 29 R. 14W

Well No. 1 Shriver

Cities Service

Company

COMPLETE

Contractor

SE NE SE

E1, 1962

SECTION PLAT

990 Ft. from N. Line

\_\_\_\_\_ Ft. from S. Line

330 Ft. from E. Line

\_\_\_\_\_ Ft. from W. Line

			o

Pratt County

RECORD

Location \_\_\_\_\_

Cased \_\_\_\_\_ in., \_\_\_\_\_ ft.

Rig up \_\_\_\_\_

Sand \_\_\_\_\_

Drilling and Remarks:

Gas \_\_\_\_\_

*Water 4434*

Oil

*Sing Sol 4487*

Total Depth 4562

*Cr 4455*

PRODUCTION

*5" 445-60*

1st 24 hrs. Nat. \_\_\_\_\_

*Prof Sing*

1st 24 hrs. after shot \_\_\_\_\_

*Flow 315 oil 44*

Gas \_\_\_\_\_ Cu. Ft.

Dry Hole \_\_\_\_\_

Abandoned \_\_\_\_\_

Date

DEC 29 1948 19

S. J. LEWIS

Scout