

Sec. 35 Twp. 29 R. 14W

Well No. #2 Shriver "B" Farm

Cities Service Company


Shriver Pool (Rine Drlg., Cont.)

990' Ft. from N. Line

_____ Ft. from S. Line

990' Ft. from E. Line

_____ Ft. from W. Line

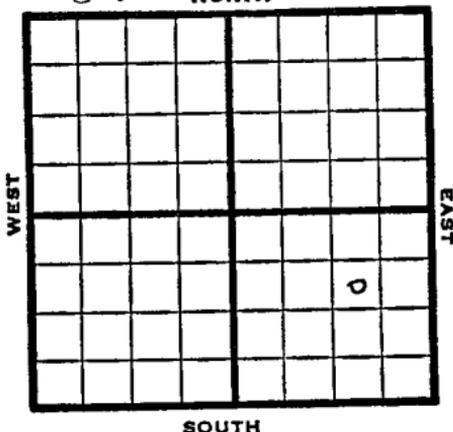

SW NE SE

1949 Elev 1970' REPORT

| | |
|-------|------------------|
| 9/21 | Location |
| 9/28 | 8" @ 410' |
| | Drlg 2550' |
| 10/5 | drlg 3344' |
| 10/12 | TD 4675' |
| | Lans 3977' |
| | Viola 4504' |
| | Simp sd 4548' |
| | Arb. 4645' |
| | Aband. |
| | ABANDONED |

Map No. _____ Sec. 35 Twp. 29 R. 14W

Well No. 2 Shriver "B"

Cities Service _____ Company

Rine Drls. _____ Contractor

SW NW SE

FIRST REPORT
SECTION PLAT

990 Ft. from N. Line

_____ Ft. from S. Line

990 Ft. from E. Line

_____ Ft. from W. Line

| | | | |
|--|--|--|---|
| | | | |
| | | | |
| | | | |
| | | | 6 |
| | | | |

Pratt County

Location _____ X

Rig up _____

Drilling and Remarks:

RECORD

Cased _____ in., _____ ft.

Sand _____

Gas _____

Oil _____

Total Depth _____

PRODUCTION

1st 24 hrs. Nat. _____

1st 24 hrs. after shot _____

Gas _____ Cu. Ft.

Dry Hole _____

Abandoned _____

Date

SEP 21 1949 19

S. J. LEWIS Scout

Kansas

Map No. _____ Sec. 35 Twp. 29 R. 14W

Well No. 2 Shriver "B"

Cities Service

Company

ABANDONED

Contractor

SW NE SE

E 11970
SECTION PLAT

| | | | |
|--|--|--|---|
| | | | |
| | | | |
| | | | |
| | | | 0 |
| | | | |

990 Ft. from N. Line

_____ Ft. from S. Line

990 Ft. from E. Line

_____ Ft. from W. Line

Pratt County

RECORD

Location _____

Cased _____ in., _____ ft.

Rig up _____

Sand _____

Drilling and Remarks:

Gas _____

Oil _____

Total Depth 4675

PRODUCTION

1st 24 hrs. Nat. _____

1st 24 hrs. after shot _____

Gas _____ Cu. Ft.

Dry Hole _____

Abandoned _____

Log 3977
Viola 4534
Amey 4645
Ray 4645

Date

OCT 12 1949 19

S. J. LEWIS

Scout