


Section 35 Township 29 Range 14W

Well No. 3 - Shriver "B"

Company Cities Service Oil

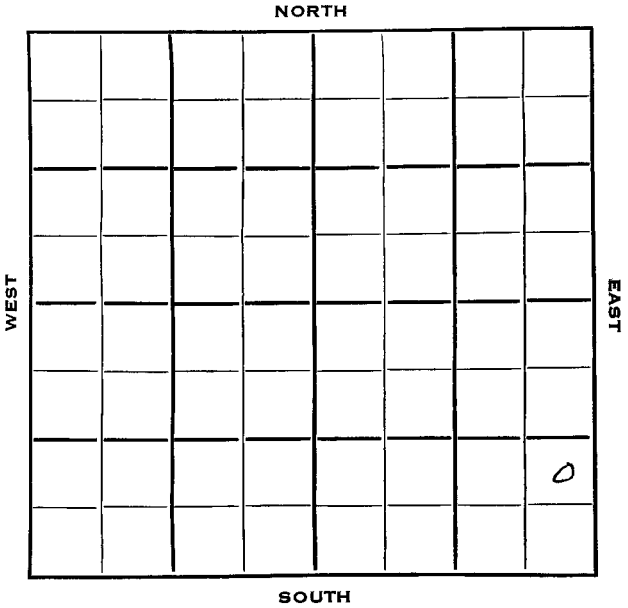

Sec. 35 Twp. 29 R. 14W

Well No. #3 Shriver "B" Farm

Cities Service Oil Company

Barbour Drlg. Contractor

Clara Pool

Ft. from N. Line

990


Ft. from S. Line

330

Ft. from E. Line

Ft. from W. Line

NE SE SE

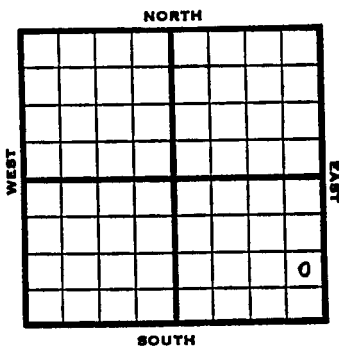

1953

REPORT

Elev. 1971

1/14

RUR

1/22

8" @ 412
Drlg. 2635'

1/29

Drlg. 4135'

2/5

Doug 3838, Br li 3955, Lans 3968

DST 4113-35, 1 hr., 420' SW 1400#

V 4422, simp 4429

DST 4438-45, 1 hr., 20' OCM, 375' oil, 5' M & W 430#

Arb. 4515

RTD 4520, Schl

5" @ 4517'

2/12

CO 4520, F 105 BO 13 hrs. G. 36.6

2/19

NR

2/26

N.R.

3/12

"

3/19

NR

3/25

Spud 1-14-53

Oil Well

TD 4520

8" @ 412

Doug 3838, Br Lime 3955

OVER

1953

Information brought forward

3/25

Lans 3968

DST 4113-35 open 1 hr. Rec 420' SW
1400#

Viola 4422, Simp 4429

DST 4438-45 open 1 hr. Rec 20' ocm
375' oil 5' mud & wtr. 430#

Arb 4515

TD 4520

5" @ 4517

CO to 4520 F/ 105 bo 13 hr.

Comp. 43 bopd 48% wtr.

COMPLETED

