


Kiowa

KANSAS

SECTION 35 TOWNSHIP 29 RANGE 17W

WELL NO. #1 Miller

COMPANY Rupp-Ferguson Oil

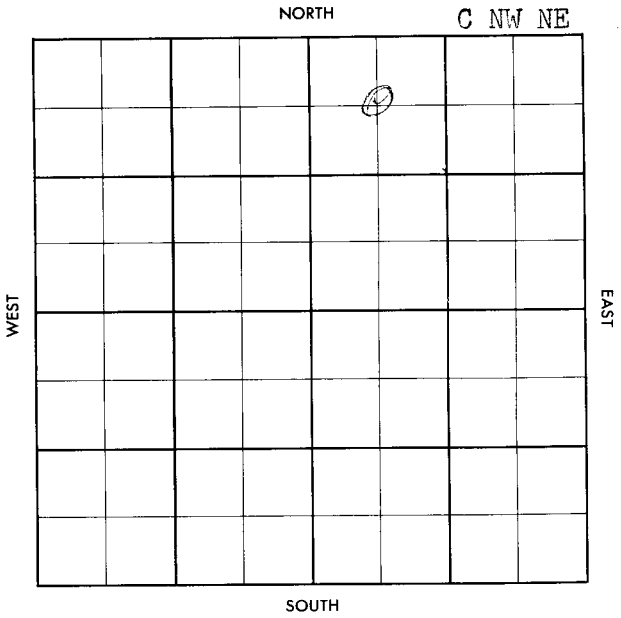

County KIOWA Elev. \_\_\_\_\_  
 Sec. 35 Twp. 29 Rge. 17W  
 Company Rupp-Gerguson Oil  
 Farm Name Miller No. 1

	TOPS	DEPTH	LOG	DATUM
Anh.				
TP.				
H.				
Tr.				
Dg.				
Bl.				
L.				
K.C.				
B.C.				
Ce.				
C.				
M.				
M.				
K.				
Nz.				
Me.				
V.				
S.				
S.				
A.				
R.				
Pe.				
G.				
TD				

Loc. in Sec. C NW NE  
 Geol. \_\_\_\_\_  
 Contr. \_\_\_\_\_  
 Co. Tools \_\_\_\_\_  
 Pool \_\_\_\_\_

APR 17 '57  
 FIRST REPORT

Date Comm. Skelly (DHM)  
MIRT

*[Handwritten signature]*

Co.  
 Loc.  
 No. 1  
 Sec.  
 T.  
 R.

County Kiowa Elev. 2089  
 Sec. 35 Twp. 29 Rge. 17W  
 Company Rupp-Gerguson Oil  
 Farm Name Millar No. 1

TOPS	DEPTH	LOG	DATUM
Anh.			
Tp.			
H.	4052		
Tr.			
Dg.			
Bl.	4213		
L.	4233		
K.C.			
B.K.C. <u>Marm</u>	4697		
Ce.	4750		
C.			
M.	4823		
M.			
K.			
Mz.			
Mo.			
V.			
S.			
S.			
A.			
R.			
PE.			
G.			
TD	4925		

Loc. in Sec. C NW NE  
 Geol. \_\_\_\_\_  
 Contr. \_\_\_\_\_  
 Co. Tools \_\_\_\_\_  
 Pool \_\_\_\_\_

	o
MAY 8 57	
ABANDONED	

Date Comm. Skelly (D.H.)  
MIRT APR 24 57 4-16-57 8578 400  
1250 @ 2965 MAY 1 57 @ 4691  
4823 57 DST 4823-43 @ 30"  
rec 12' Md + 550 BHP 0 DST  
4843-78 @ 1 hr rec 65'  
Md. BHP 485/20"  
D&W

Co.  
 No.  
 Sec.  
 T.  
 R.