


Kingman

SECTION 35 TOWNSHIP 29S RANGE 9W KANSAS

WELL NO. #1 Wright "B"

COMPANY C. S.O.

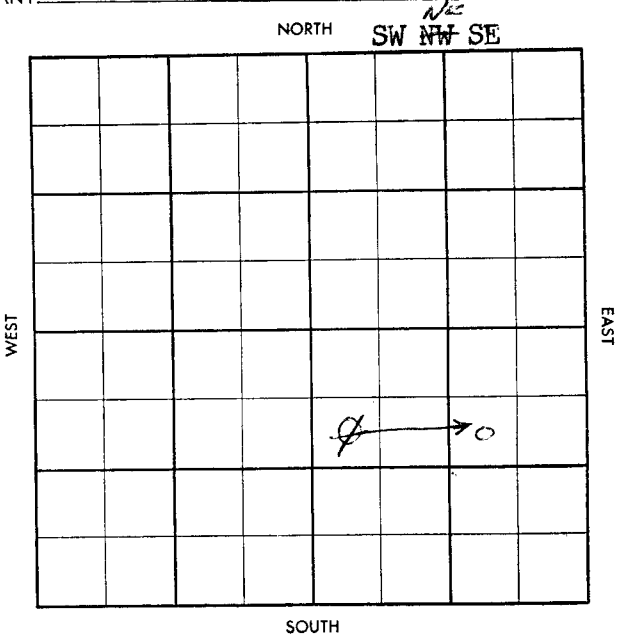

Twp. X Pool X
Co. X Facet X

-513-B

County Kingman Elev. _____
Sec. 35 Twp. 29 Rge. 9W
Company C. S. O.
Farm Name Wright "B" No. 1


TOPS	DEPTH	LOG	DATUM
Anh.			
Tp.			
H.			
Tr.			
Dg.			
B.L.			
L.			
K.C.			
B.K.C.			
Ce.			
C.			
M.			
M.			
K.			
Mz.			
Mq.			
V.			
S.			
S.			
A.			
R.			
Pf.			
G.			
T.D.			

Loc. in Sec. SW NW SE

Geol. _____

Contr. _____

Pool _____

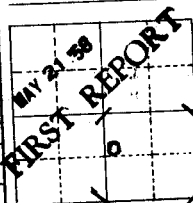

Date Comm. _____

Location

140 Pool ✓
 10
 CORRECTION

8-513-B

County Kingman Elev. 15810 15848
 Sec. 35 Twp. 29 Rge. 9W
 Company C. S. O.
 Farm Name Wright "B" No. 1

TOPS	DEPTH	LOG	DATUM
Anh.			
Tp.			
H.	3270		
Tr.	3281		
Dg.	3310		
B.L.			
L.	3490		
K.C.			
B.K.C.			
Ce.			
C.			
M.	4155	4166	
M.			
K.			
Mz.			
Mq.			
V.			
S.			
S.			
A.			
R.			
Pf.			
G.			
T.D.	4260		

Loc. in Sec. SW NW SE
SW NE SE

Geol. _____
 Contr. Prime
 Pool W.C.

COMPLETE
 AUG 13

Date Comm. 6-2-58 8' 413/250 1/2 mi Co. A
 Location MAY 28 '58 JUN 3 '58 JUN 11 '58 03460
JUN 18 '58 DST 4168-78 60" g/1 1/2"
ga 2.190 mcf 35' M+6W BHP 1440
DST 4178-90 JUN 25 '58 1 hr g/3" ga
1.250 mcf 95' M+5W FP 150-165
BHP 1470-1840/20" DST 4190-4200
1 hr g/6" ga 62 mcf rec 80' M 77
M+5W FP 45-65 BHP 1480-1235
DST 4200-10 60" 130' 506 g/cm

77' SW BHP 1470 - 1250/30
 DST 4210-20 60" 80' 50 CM
 37' M6W BHP 1490 - 1445/30"
 DST 4220-30 14v 96' M6W BHP
 1475 - 1430/30" Log 4" 4260 JUL 2 58
 JUL 9 58 CO 4233 47/4156-64
 9A 986 mcf from SXS 522.
 536 mcf + Lx FCP 600
 JUL 16 58 JUL 23 58 F10 7 1/2 BO 27BW
~~1311~~ 5h- 3.330 mcf SXP
 1311 JUL 30 58 AUG 6 58 AUG 13 58
 3.330 MCFpd 8BO 27BW
 5hrs SIP 1311
 Miss 4156-64

¢