Kingman

KANSAS

SECTION 35 TOWNSHIP 29S RANGE 7W

WELL NO. #1 Hibbs

COMPANY Tom Allan

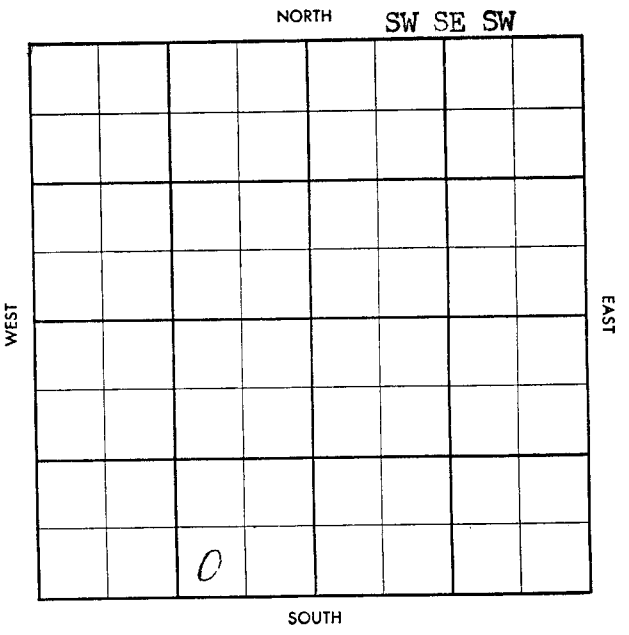

S-513-B

Co.

County Kingman Elev.

Sec. 35 Twp. 29 Rge. 7W

Company Tom Allan

Farm Name Hibbs No. 1

TOPS	DEPTH	LOG	DATUM
Anh.			
Tp.			
H.			
Tr.			
Dg.			
B. L.			
L.			
K.C.			
B.K.C.			
Ce.			
C.			
M.			
M.			
K.			
Mz.			
Mq.			
V.			
S.			
S.			
A.			
R.			
Pf.			
G.			
T.D.			

Loc. in Sec. SW SE SW

Geol.

Contr. Co. Tools

Pool Trenton

Sec. Twp. Rge.

FIRST REPORT

Date Comm. Co. Tools

Lse.

No.

Sec.

T.

R.

Twp. X Pool

Co. X Feet X

S-513-B

County Kingman Elev 14[illegible] = 14[illegible]

Sec. 35 Twp. 29 Rge. 7W

Company Tom Allan

Farm Name Hibbs No. 1

TOPS	DEPTH	LOG	DATUM
Anh.			
Tp.			
H.			
Tr.			
Dg.			
B.L.			
L.			
K.C.	3287		
B.K.C.			
Ce.			
C.			
M.	4108		
M.			
K.			
Mz.			
Mq.			
V.			
S.			
S.			
A.			
R.			
Pf.			
G.			
T.D.	4130		

Loc. in Sec. SW SE SW

Geol.

Contr. Co. Tools

Pool Trenton

COMPLETE

JUN 3 '58

Date Comm. 4-16-58 8" 255/170

Co. Tools APR 23 '58 ø 2400 APR 30 '58

ø 3906 MAY 7 no log 5" 4123/125

Co 4130 HF of oil MAY 1[illegible] 58

F/o 180 BO 24 hrs 1/4" chk

FCP 760-800# MAY 21 '58 MAY 28 '58

JUN 3 '58 F/o 180 Bopd NW

thru csg

Co. Lse. No. Sec. T. R.