Kingman KANSAS

SECTION 35 TOWNSHIP 29 RANGE 8W

WELL NO. #1 Richardson

COMPANY Pickrell Drlg.

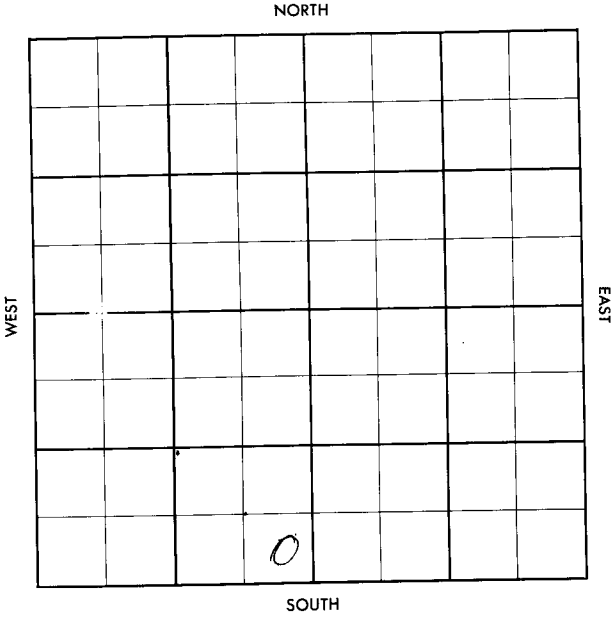

FORM 504-3 SUNRAY

FORM 513 SUNRAY

County Kingman Elev.

Sec. 35 Twp. 29 Rge. 8W

Company Pickrell Drlg.

Farm Name Richardson No. 1

TOPS	DEPTH	LOG	DATUM
Anh.			
T.P.			
H.			
Tr.			
Dg.			
B.L.			
L.			
K.C.			
B.K.C.			
Ce.			
C.			
M.			
M.			
K.			
Mz.			
Mc.			
V.			
S.			
S.			
A			
R.			
P€.			
G.			
TD			

Loc. in Sec. SE SE SW

Geol.

Contr. Co. tools

Pool Spivey-Grabs

FIRST REPORT
DEC 12 '56

Date Comm. 12-6-56 Gulf - FO

8" @ 200 drlg. 2357

27

Lo. Lse. No. Sec. T. R.

FORM 513 SUNRAY

County Kingman Elev. 1541

Sec. 35 Twp. 29 Rge. 8W

Company Pickrell Drlg.

Farm Name Richardson No. 1

TOPS	DEPTH	LOG	DATUM
Anh.			
Tp.			
H.			
Tr.			
Dg.			
Bl.			
L.	3404		
K.C.			
B.K.C.			
Cc.			
C.			
M.	4158		
M.			
K.			
Mz.			
Mo.			
V.			
S.			
S.			
A			
R.			
P€.			
G.			
T.D.	4265		

Loc. in Sec. SE SE SW

Geol.

Contr. Co. tools

Pool Spivey-Grabs

JAN 30 57

COMPLETE

Date Comm. 12-6-56 Gulf - FO

8" @ 200 drlg. 2357 DEC 10 '56

DST 4161-95 op 1hr ga 500

MCFG rec 103' GCM BHP 1150

115" DST 4200-35 1hr rec 500'

HO & GCM + 1080 gssy oil BHP

1500 Rng Log DEC 20 '56 4 1/2 @

4258/150 JAN 2 '57 CO 4235 64/4210

-26 2" Tbg to 4228 & 5 BFph

Frac Av. 16 Boph 15 hrs 3/4"

Co. Lse. No. Sec. T. R.

FORM 513-1 SUNRAY

ch 16½ Bopd CP 420 #
TP 25 # JAN 9 '57 S. I. JAN 10 '57
JAN 6 '57
Ph Flw 234 Bopd
18/64" ch. TP 400 # CP 480 #
gas ga. 202 MCFG GOR 863:1