Kingman KANSAS

SECTION 35 TOWNSHIP 29 RANGE 8W

WELL NO. #1 V.L. Cline

COMPANY Sinclair O&G

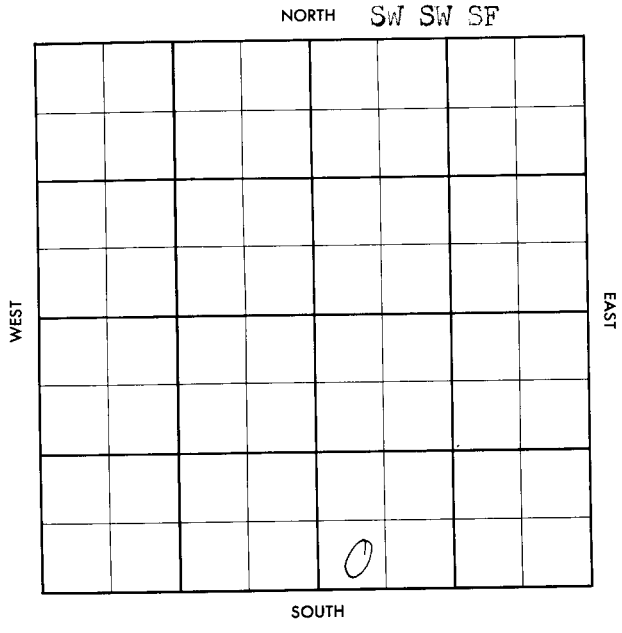

FORM 504-3 SUNRAY

FORM 513 SUNRAY

County Kingman Elev.

Sec. 35 Twp. 29 Rge. 6W

Company Sinclair O & G

Farm Name V. L. Cline No. 1

TOPS	DEPTH	LOG	DATUM
Anh.			
Tp.			
H.			
Tr.			
Dg.			
Bl.			
L.			
K.C.			
B.K.C.			
Ce.			
C.			
M.			
M.			
K.			
Mz.			
Mc.			
V.			
S.			
S.			
A			
R.			
Pc.			
G.			
TD			

Loc. in Sec. SW SW SE

Geol.

Contr.

Pool Spivey-Grab

FIRST REPORT
JAN 23 '57
O

Date Comm.

Location

Co.

Lse.

No.

Sec.

T.

R.

FORM 518 SUNRAY

County Kingman Elev. 1544

Sec. 35 Twp. 22 Rge. 8W

Company Sinclair O & G

Farm Name W. L. Cline No. 1

TOPS	DEPTH	LOG	DATUM
Anh.			
Tp.			
H.	3165	3165	
Tr.			
Dg. Sh	3200	3200	
Bt. Dgid	3296	3299	
L.	3391	3395	
K.C.			
B.K.C.			
Ce.			
C.			
M. Chat	4141	4142	
M. Ls	4208		
K.			
Mz.			
Me.			
V.			
S.			
S.			
A			
R.			
Pe.			
G.			
T.D.	4290	4293	

Loc. in Sec. SW SW SW

Geol.

County

Pool Spivey-Grab.

MAR 27 '57

COMPLETE

Date Comm.

Location JAN 30 '57 1-27-57

10 3/4 235 FEB 6 '57 Ø 3985 FEB 13 '57

DST 4144-70 90" G/2"

stabil 2,930 MCF/15" no 58'

GCM +60' 9554 SW FP 400-400

BHP 1490/30 DST 4198-4208

2 hrs 35' oil spkd ND FT

25-25 BHP 400/30" DST

4165-4208 3 hrs G/4" stabil

FORM 513-1 SUNRAY

747 MCF/1 hr rec 40' GCM
+120' GCSW FP 96-150
BHP 1525/30" 5½ @ 4289/200
FEB 20 '57 CO 204/4148-82 1/2 ~~[illegible]~~
tst 1.628 MCFG + Ld FEB 27 '57
Frac ~~[illegible]~~ 300 MCFG
Fluid Ld + 400 MCFG 1" ch
TP 125 CP 425 [illegible] '57 WO POT
MAR 13 '57 MAR 20 '57 MAR 27 '57 Cal. of Flow
3. 300 MCFGPD TP 900 CP 1015

35-29-8