


DX 78-1 Haskell

KANSAS

Section 35 Township 29S Range 32W

Well No. #1 Burgmeir

Company Kans-Nebraska

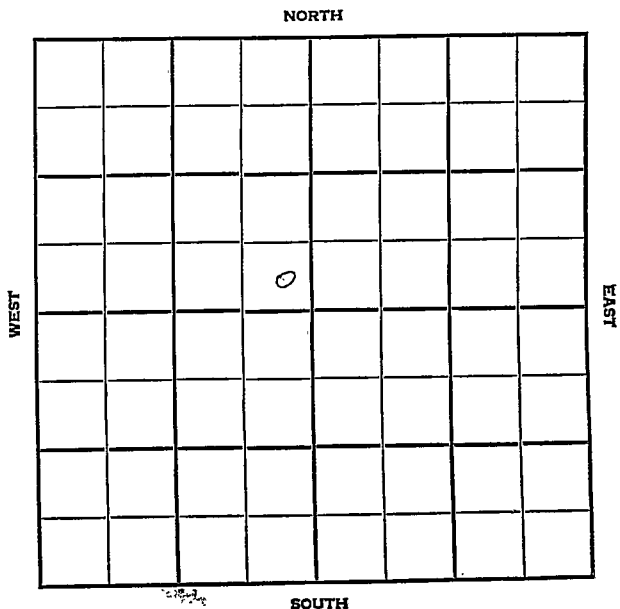

Haskell

KANSAS

SEC.

TWP.

R.

35

29

32W

WELL NO.

#1 Burgmeier

COMPANY

FARM

Kans-Nebraska

CONTRACTOR

Bennett & Roberts

150

~~###~~

FT. FROM N. LINE

FT. FROM S. LINE


FT. FROM E. LINE

150

~~###~~

FT. FROM W. LINE

SE SE NW

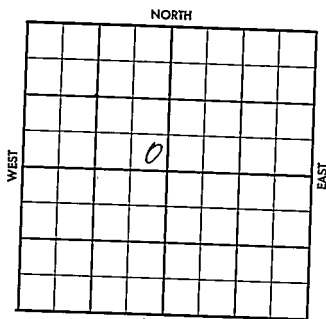

Champ - FO

1956

ELEVATION

2893'

REPORT

7-25

Comm. 7-22-56
8" @ 565 w/300
WOC

County HaskellElev. 2893Sec. 35Twp. 29SRge. 32WCompany Kans-NebraskaFarm Name BurgmeierNo. 7

TOPS	DEPTH	LOG	DATUM
Anh.			
Sp.			
H.			
Tr.			
Dg.			
BL.			
L.			
K.C.			
B.K.C.			
Ce.			
C.			
M.			
M.			
K.			
Mz.			
Ma.			
V.			
S.			
S.			
A.			
R.			
Pe.			
G.			
T.D.			

Loc. in Sec. SE SE NW150' N & 150'W of CenGeol. Bennett & RobertContr. HugotonPool JUL 25 1956FIRST REPORTDate Comm. 7/22/56

Champ - FO

8" 565 w/300 WOC

CUBI

I JUN

.00 .01

County Haskell Elev. 2893
 Sec. 35 Twp. 29S Rge. 32W
 Company Hans-Nebraska
 Farm Name Burgmeier No. 7

TOPS	DEPTH	LOG	DATUM	Loc. in Sec.
Anh. <u>Herr</u>		<u>2669</u>		SE SE NW
Tr. <u>PER</u>		<u>2693</u>		
H. <u>WFD</u>		<u>2744</u>		150' N & 150'
Tr.				W of Cen
Dg.				Geol.
Bl.				Contr.
L.				Bennett & Robert
N.C.				Pool
B.K.C.				Hugoton
Ce.				
C.				
M.				
M.				
K.				
Mz.				
Mo.				
V.				
S.				
S.				
A.				
R.				
PE.				
G.				
TD.	<u>2755</u>			

Date Comm. 7/22/56 Champ - FO

8" 565 W/300. WOC AUG 1 '56 5 1/2 @ 2749

1200 AUG 8 '56 AUG 15 '56 AUG 22 '56

AUG 29 '56 SEP 5 '56 DD 2762 TD 9a

657 MCF 11 9a 1.39 MCF +

60 GSWPH, PB 2728 56/2670

-84 80/2698-2718 F2C 9a

4.424 MCF SEP 12 '56 SEP 19 '56 SEP 26 '56

9a 4.424 MCF 6-PD.