


Section 36 Township 29 Range 14W

Well No. 1 Earlywine

Company Lion Oil

Clara Pool
NORTH

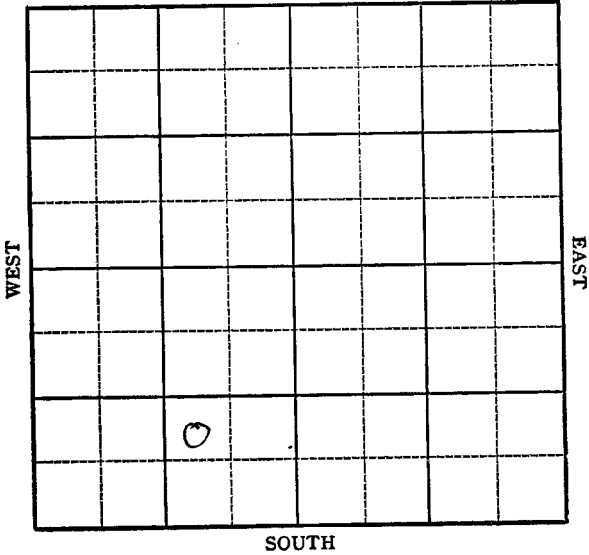

KANSAS

Pratt



Sec. 36 Twp. 29 R. 14W

Well No. #1 Earlywine Farm
Lion Oil Company

Clara Pool


_____ Ft. from N. Line

990' Ft. from S. Line

990' Ft. from E. Line

_____ Ft. from W. Line

NW SE SW

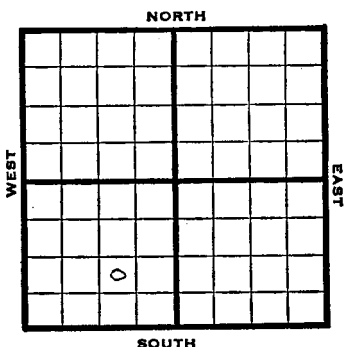

1948 Elev. 1941' REPORT

9/8 8" @ 388'
Drlg. 2045'

9/14 Drlg. 4046'

9/22 Lans 3988'
Viola 4535'
Simp Sd 4574'
TD 4583'

ABANDONED

Pratt County Kansas State

Map No. _____ Sec. 36 Twp. 29 R. 14W


Well No. 1 Earlywine

Lion Oil Company

-IRST REPORT Contractor

NW SE SW

SECTION PLAT

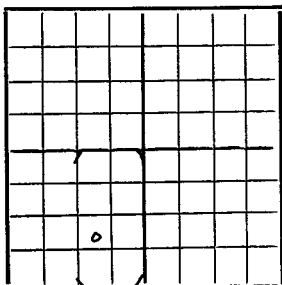

_____ Ft. from N. Line

990 Ft. from S. Line

990 Ft. from E. Line

_____ Ft. from W. Line

Clara Pool

Remarks:

8" @ 388 drlg. 2045

Date
SEP 6 1948

Scout S. J. LEWIS

