


Section 36 Township 29 Range 14W

Well No. 2 Earlywine

Company Roberts, Murphy et al

Clara Pool

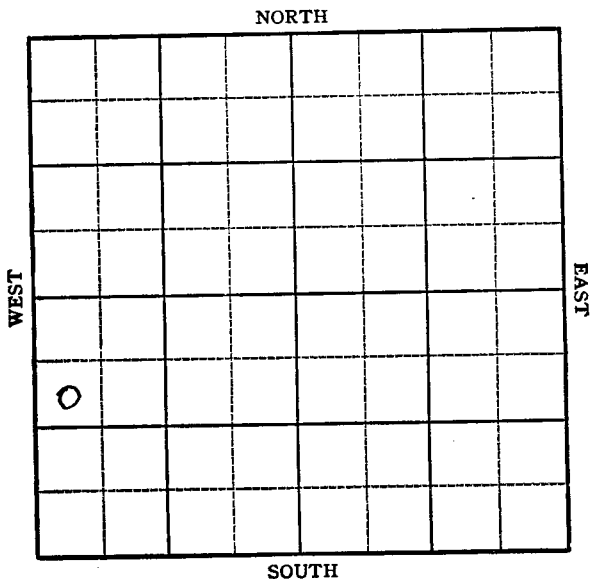

Sec. 36 Twp. 29 R. 14W

Well No. 2 Earlywine Farm

Roberts, Murphy et al Company

Clara Pool


990 Ft. from N. Line

 Ft. from S. Line

 Ft. from E. Line

330 Ft. from W. Line

SW NW SW

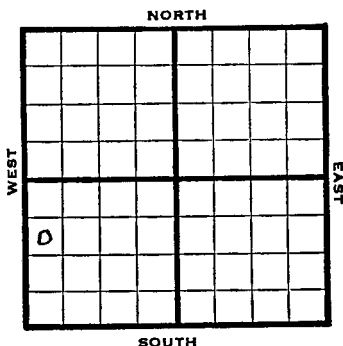

1948	Eli 1949'	REPORT
9/22	Location	
9/29	8" @ 359'	Drlg. 960'
10/6	Lansing 3960'	Drlg. 4061'
10/13	Viola 4.19'	Simp sd 4477'
	Arb. 4557'	TD 4566'
	5" @ 4560'	
10/19	93 shots 4485-4506	HFO
10/26	"	
11/3	Pump & flow 12 bbls oil PH 8 hrs.	
11/10	TD 4566'	
	S imp Sd 4477'	
	Arb. 4557'	
	5"@ 4560'	
	Perf Simp	
	Echo Pot 1291 Oil	
	40° Gr.	
	Comp	
	COMPLETED	

Pratt County Kansas StateMap No. _____ Sec. 36 Twp. 29 R. 14WWell No. 2 EarlywineRoberts, Murphy et al. Company

FIRST REPORT

Contractor

SW NW SW

SECTION PLAT

990 Ft. from N. Line

_____ Ft. from S. Line

_____ Ft. from E. Line

330 Ft. from W. Line

D

Clara Pool

Remarks: _____

Location

Date
SEP 22 1948

Scout S. J. LEWIS

Map No. 92 Sec. 36 Twp. 29 R. 14W

Well No. 2 Earlywine

Roberts, Murphy et al. Company

COMPLETE Contractor

SW NW SW

E 1, 1948
SECTION PLAT

0			

990 Ft. from N. Line

Ft. from S. Line

Ft. from E. Line

330 Ft. from W. Line

Pratt County

RECORD

Location _____

Cased _____ in., _____ ft.

Rig up _____

Sand _____

Drilling and Remarks:

Gas _____

Oil ☒

Total Depth 4566

PRODUCTION

1st 24 hrs. Nat. _____

1st 24 hrs. after shot _____

Gas _____ Cu. Ft.

Dry Hole _____

Abandoned _____

Date

NOV. 10 1948 19

S. J. LEWIS

Scout