Kingman KANSAS

SECTION 36 TOWNSHIP 29 RANGE 7 W

WELL NO. #1 ~~DeWeese~~ Barney

COMPANY ~~Wilcox Oil~~

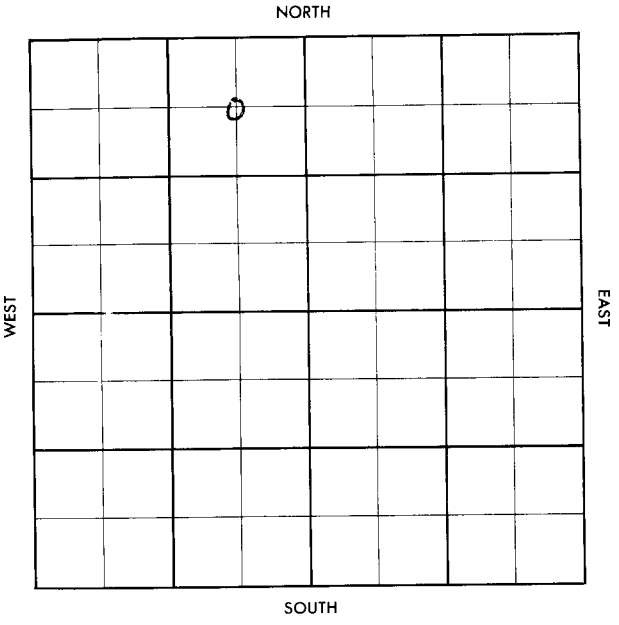

FORM 513 REV. SUNRAY

Co.

County Kingman Elev.

Sec. 36 Twp. 29 Rge. 7W

Company Wilcox Oil

Farm Name DeWeese No. 1

TOPS	DEPTH	LOG	DATUM
Anh.			
Tp.			
H.			
Tr.			
Dg.			
Bl.			
L.			
K.C.			
B.K.C.			
Ce.			
C.			
M.			
M.			
K.			
Mz.			
Mo.			
V.			
S.			
S.			
A			
R.			
P€.			
G.			
T.D.			

Loc. in Sec. C NE NW

Geol.

Contr.

Lse.

Pool Wildcat

O

JAN 25 '46

FIRST REPORT

No.

Pure & Sunray Mid-Continent

Sec.

DRL

Date Comm.

Location

FORM 513 REV SUNRAY

County Kingman Elev. 1483

Sec. 36 Twp. 29 Rge. 7W

Company Wilcox Oil

Farm Name ~~DeWeese~~ Barney No. 1

TOPS	DEPTH	LOG	DATUM
Anh.			
Tp.			
H.	3025		
Tr.			
Dg. Sh	3060		
Bl.			
L.	3265		1782
K.C.	3545		2062
B.K.C.	3793		2310
Ce.			
C.			
M.	4118?		2635
M.			
K.			
Mz.			
Mo.			
V.			
S.			
S.			
A			
R.			
PC.			
G.			
TD.	4245		

Loc. in Sec

C NE NW

Geol. Ted Fischer DSM Court Harper Kans

Contr.

Pool

Wildcat

FEB 15 1956

ABANDONED

Date Comm. Pure & Sunray Mid-Continent

Location FEB 1 '56 Spud 1-27-56 DBE

8 5/8 175/150 @ 1630 FEB 8 '56

PTD 4151 (Will run DST) FEB 15 '56 DST

4121-55 ore 36" rec 10' Md FP

35-42# BHP 55/20" Ran Log

[illegible]