Sec. 36 Twp. 29s Range 7W

#1 Barney

Kansas Geological Society

Wilcox Oil

Skelly Scout Tickets

Kingman

SEC.	TWP.	R.
36	29S	7 W

WELL NO. # 1 ~~De Weese~~ Barney (BARNEY) FARM

COMPANY Wilcox Oil

CONTRACTOR

Wildcat

_____ Ft. from N. Line

_____ Ft. from S. Line

_____ Ft. from E. Line

_____ Ft. from W. Line

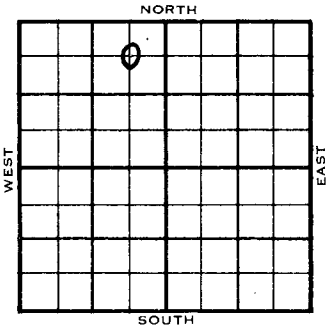

C NE NW
Pure & SDX - DHM $2,500.00

ELEVATION 1483' REPORT (TWH6-DC1)

1956	
1/25	Mississippian test well @ 4,150' Location (F.R.Tkt) Spud 1-27-56
1/26	Set 8-5/8" @ 175 w/150 sax.
1/27	Drlg. 663'
1/28	No report.
1/29	Drlg. 1630' (Tel - Wilcox Oil)
2/1	Drlg. 2775' Heeb 3025', Doug sh. 3060
2/2	Drlg. 3142' Lans. 3265', KC 3545',
/3	Drlg. pipe stuck @ 3355'. B KC 3793', Miss 4118' "
2/6	Drlg. 3920' "
2/7	Drlg. 4136'. No tops. "
2/8	Top Miss. 4120' Took DST 4121-51, open 36 mins, weak blow, went dead, rec 10' mud. SIP 55# 20". Drilled TD 4245', Rng Elec. Log. (Tel-Wilcox Oil)
2/9	TD 4246' Schl. T. Miss 4120' DST #1, 4121-51, open 36 min, weak blow, died in 36 mins. rec 10' drlg. mud. HP 2262#. IFP 35#. FFP 42# SIP 55# 20".
OVER	TD 4246' Ran Log. D & A. (Tel-Wilcox Oil)
2/13 DX-78	Received 2 copies of Laterolog Survey -Given to S.A. Shannon-Div. Geolog.

1956

2/15 Advised Contract Section - D & A

2/16 Received Well plugging Application & Well plugging record. Given to S.A. Shannon-Div. Geolog.