Kingman


KANSAS

36 29 8W

SECTION TOWNSHIP RANGE

WELL NO. #1 Albright

COMPANY Rupp-Ferguson

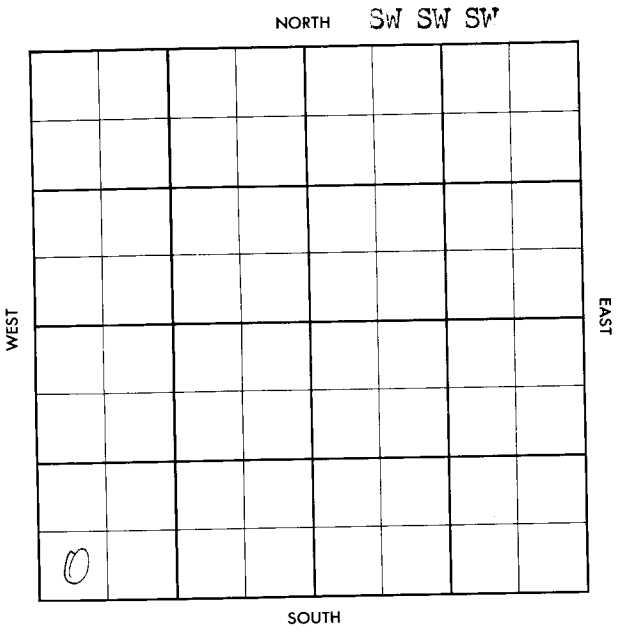

FORM 504-3 SUNRAY

FORM 513 SUNRAY

County Kingman Elev.

Sec. 36 Twp. 29 Rge. 8W

Company Rupp-Ferguson

Farm Name Albright No. 1

TOPS	DEPTH	LOG	DATUM
Anh.			
T.P.			
H.			
Tr.			
Dg.			
B.L.			
L.			
K.C.			
B.K.C.			
Ce.			
C.			
M.			
M.			
K.			
Mz.			
Mc.			
V.			
S.			
S.			
A			
R.			
Pe.			
G.			
TD			

Loc. in Sec. SW SW SW

Geol.

Contr. Sierra Tools

Pool Spivey-Grabs

FIRST REPORT

FEB 20 '57

Date Comm. 2-14-57 Gulf (FO)

8" @ 205/135 Drlg. 2525

Co.

Lse.

No.

Sec.

T.

R.

FORM 513 SUNRAY

County Kingman Elev. 1566

Sec. 36 Twp. 29 Rge. 8W

Company Rupp-Ferguson

Farm Name Albright No. 1

TOPS	DEPTH	LOG	DATUM
Anh.			
T.P.			
H.	3195		
Tr.			
Dg.	3222		
Bl.			
L.	3422		
K.C.			
B.K.C.	3919		
Ce.			
C.			
M.	4170		
M.			
K.			
Mr.			
Mo.			
V.			
S.			
S.			
A			
R.			
Pe.			
G.			
T.D.	4270		

Loc. in Sec. SW SW SW

Geol.

Contr. Sierra Tools

Pool Spivey-Grabs

ABANDONED

MAR 6 '57

Date Comm. 2-14-57 Gulf (FO)

8⅝" @ 205/135 Drlg. 2525 ID 3962

DST 4171-89 1hr wk

36' Md BHP 200

P&A

Co. Lse. No. Sec. T. R.