DX 78-1


Kingman

KANSAS

Section 36 Township 29 Range 8W

Well No. #1 Albright

Company Gulf Oil Corp.

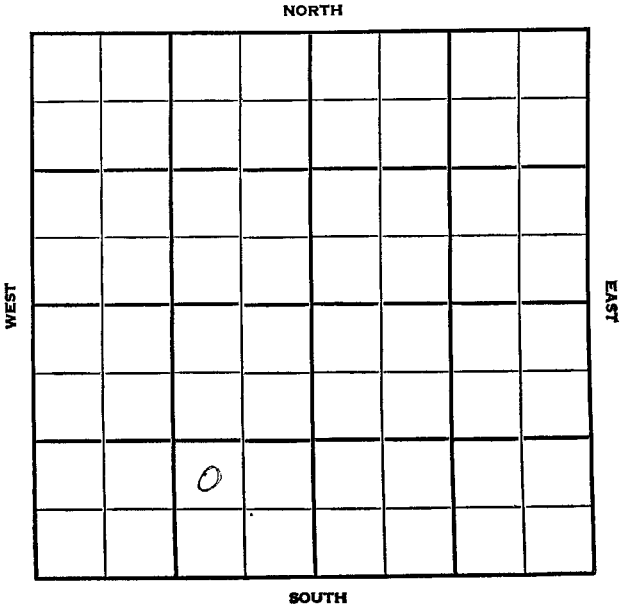

FORM 513 SUNRAY

County Kingman Elev.

Sec. 36 Twp. 29 Rge. SW

Company Gulf Oil Corp

Farm Name Albright No. 1

TOPS	DEPTH	LOG	DATUM
Anh.			
Tp.			
H.			
Tr.			
Dg.			
Bl.			
L.			
K.C.			
B.K.C.			
Ce.			
C.			
M.			
M.			
K.			
Mz.			
Mo.			
V.			
S.			
S.			
A			
R.			
Pe.			
G.			
T.D.			

Loc. in Sec. NW SE SW

Geol.

Contr. Lewis Drlg.

Pool Berthalf

FIRST REPORT

OCT 24 '56

Date Comm.

MIRT

BERT'S VON

Co. Lse. No. Sec. T. R.

FORM 513 SUNRAY

County Kingman Elev. 1561

Sec. 36 Twp. 29 Rge. 8W

Company Gulf Oil Corp

Farm Name Albright No. 1

TOPS	DEPTH	LOG	DATUM
Anh.			
Tp.			
H.		3119	
Tr.			
Dg. sh		3221	
Bi- Dg sd		3339	
L.		3418	
K.C.			
B.K.C. Marm		3897	
Ce.		4082	
C.			
M. Chert	4173	4179	
M. Li	4192	4199	
K.			
Mz.			
Me.			
V.			
S.			
S.			
A			
R.			
Pe.			
G.			
TD	4215		

Loc. in Sec. NW SE SW

Geol.

Contr. Lewis Drlg.

Pool Berthold

ABANDONED NOV 6 '56

Date Comm.

MIRT OCT 31 '56 10-22-56 85/8

215/200 Ø 3320 NOV '56 Ø 4207

NOV 13 '56 DST 4174-4214 1hr

rec 160' SGCM FP 65-65 BHP

835/30" DST 3867-85 1hr rec

5' Md FP 45-45 BHP 45/30

D&A