

Section 36 Township 29 Range 39N

Well No. #1 Bailey

Company Stanolind

Hugoton Pool

NORTH

WEST

EAST

				0			

SOUTH

KANSAS

Stanton

Sec. 36 Twp. 29 R. 39W

Well No. #1 Bailey Farm

Stanolind Company

Hugoton Pool


 Ft. from N. Line

150' Ft. from S. Line

 Ft. from E. Line

150' Ft. from W. Line

SW NE

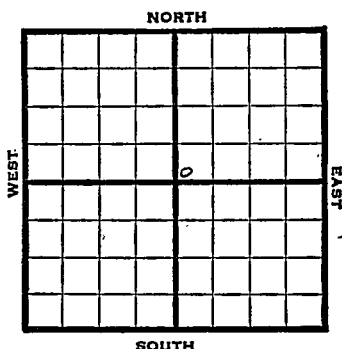

1948

Elev. 3163' REPORT

3/31

RUR

4/7

10" @ 585'

TD 2345'

7" @ 2327'

RUST

4/14

Dr1g. 2460'

4/21

TD 2557'

242' of 5" Perf liner @ 2557'

19,500 acid

4/28

"

5/5

7" @ 2327'

242' of 5" Perf liner @ 2557'

Acid 19,500

Gas 8,875,000

R. Pr. 440#

TD 2557'

COMPLETED

Map No. _____ Sec. 36 Twp. 29 R. 39W

Well No. 1 Bailey

Stanolind Company

FIRST REPORT Contractor

SW NE

SECTION PLAT

_____ Ft. from N. Line

150 Ft. from S. Line

_____ Ft. from E. Line

150 Ft. from W. Line

Stanton County

Location _____

Rig up _____

Drilling and Remarks:

R U R

RECORD

Cased _____ in., _____ ft.

Sand _____

Gas _____

Oil _____

Total Depth _____

PRODUCTION

1st 24 hrs. Nat. _____

1st 24 hrs. after shot _____

Gas _____ Cu. Ft.

Dry Hole _____

Abandoned _____

Date

MAR 31 1948 19 _____ S. J. LEWIS Scout

Map No. _____ Sec. 36 Twp. 29 R. 39W

Well No. 1 Bailey

Stanolind Company

COMPLETE

Contractor

SW NE

E1316
SECTION PLAT

_____ Ft. from N. Line

150 Ft. from S. Line

_____ Ft. from E. Line

150 Ft. from W. Line

Stanton County

Location _____

Rig up _____

Drilling and Remarks:

7" @ 2327

242' of 5" Prof. line

@ 2557

19500 acid

8,875,000 lbs

440# R.P.

RECORD

Cased _____ in., _____ ft.

Sand _____

Gas _____

Oil _____

Total Depth 2557

PRODUCTION

1st 24 hrs. Nat. _____

1st 24 hrs. after shot _____

Gas _____ Cu. Ft.

Dry Hole _____

Abandoned _____

Date

MAY 5 1948

19

S. J. LEWIS

Scout