

STATE CORPORATION COMMISSION OF KANSAS  
OIL & GAS CONSERVATION DIVISION  
WELL COMPLETION OR RECOMPLETION FORM  
ACO-1 WELL HISTORY  
DESCRIPTION OF WELL AND LEASE

Operator: License # 5398  
Name ARCO OIL AND GAS COMPANY  
Address Box 1610  
City/State/Zip Midland, Texas 79702

Purchaser Northern Natural Gas Company

Operator Contact Person Ken W. Gosnell  
Phone 915/688-5672

Contractor: License # 03098  
Name Exeter

Wellsite Geologist  
Phone

Designate Type of Completion

New Well  Re-Entry  Workover  
 Oil  SWD  Temp. Abd  
 Gas  Inj  Delayed Comp.  
 Dry  Other (Core, Water Supply etc.)

If **OWWO**: old well info as follows:  
Operator  
Well Name  
Comp. Date Old Total Depth

WELL HISTORY

Drilling Method:  
 Mud Rotary  Air Rotary  Cable  
7-30-88 8-1-88 8-18-88  
Spud Date Date Reached TD Completion Date  
2800 2730  
Total Depth PBDT

Amount of Surface Pipe Set and Cemented at 780 feet  
Multiple Stage Cementing Collar Used? Yes  No  
If yes, show depth set feet  
If alternate 2 completion, cement circulated from feet depth to w/ SX cmt  
Cement Company Name  
Invoice #

API NO. 15-067-20798  
County Grant  
SE NW NW Sec. 32 Twp. 29 Rge. 38 East  West

4026 Ft North from Southeast Corner of Section  
3975 Ft West from Southeast Corner of Section  
(Note: Locate well in section plat below)


Lease Name G. R. Hickok "H" Unit Well # 3

Field Name Hugoton

Producing Formation Chase

Elevation: Ground 3091 KB 3101

Section Plat

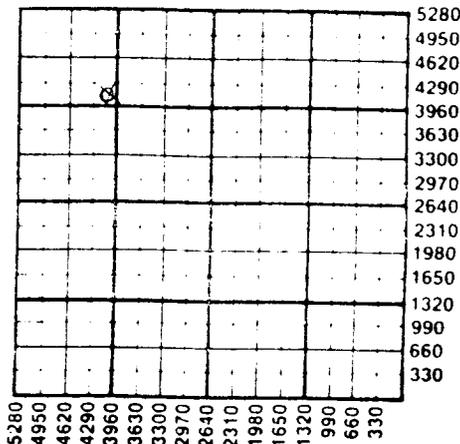

WATER SUPPLY INFORMATION

Disposition of Produced Water: Disposal  
Docket # Repressuring

Questions on this portion of the ACO-1 call:

Water Resources Board (913) 296-3717

Source of Water:  
Division of Water Resources Permit # T88-378

Groundwater 2832 Ft North from Southeast Corner  
(Well) 1584 Ft West from Southeast Corner of  
Sec 32 Twp 29 Rge 38 East  West

Surface Water Ft North from Southeast Corner  
(Stream, pond etc) Ft West from Southeast Corner  
Sec Twp Rge East West

Other (explain)  
(purchased from city, R.W.D. #)

INSTRUCTIONS: This form shall be completed in triplicate and filed with the Kansas Corporation Commission, 200 Colorado Derby Building, Wichita, Kansas 67202, within 120 days of the spud date of any well. Rule 82-3-130, 82-3-107 and 82-3-106 apply. Information on side two of this form will be held confidential for a period of 12 months if requested in writing and submitted with the form. See rule 82-3-107 for confidentiality in excess of 12 months. One copy of all wireline logs and drillers time log shall be attached with this form. Submit CP-4 form with all plugged wells. Submit CP-111 form with all temporarily abandoned wells.

All requirements of the statutes, rules and regulations promulgated to regulate the oil and gas industry have been fully complied with and the statements herein are complete and correct to the best of my knowledge.

Signature  
Title Engr. Tech. Date 11-15-88

Subscribed and sworn to before me this 15 day of November 1988

Notary Public LISA A. GORDY

Date Commission Expires 9-9-92

LISA A. GORDY  
Notary Public, State of Texas  
My Comm. Expires 6-6-92

K.C.C. OFFICE USE ONLY  
 Letter of Confidentiality Attached  
 Wireline Log Received  
 Drillers Timelog Received  
Distribution  
 KCC  SWD/Rep  NGPA  
 KGS  Plug  Other  
(Specify)