


KANSAS

Section 4 Township 29 Range 14W

Well No. #1 Luther

Company Flynn Oil

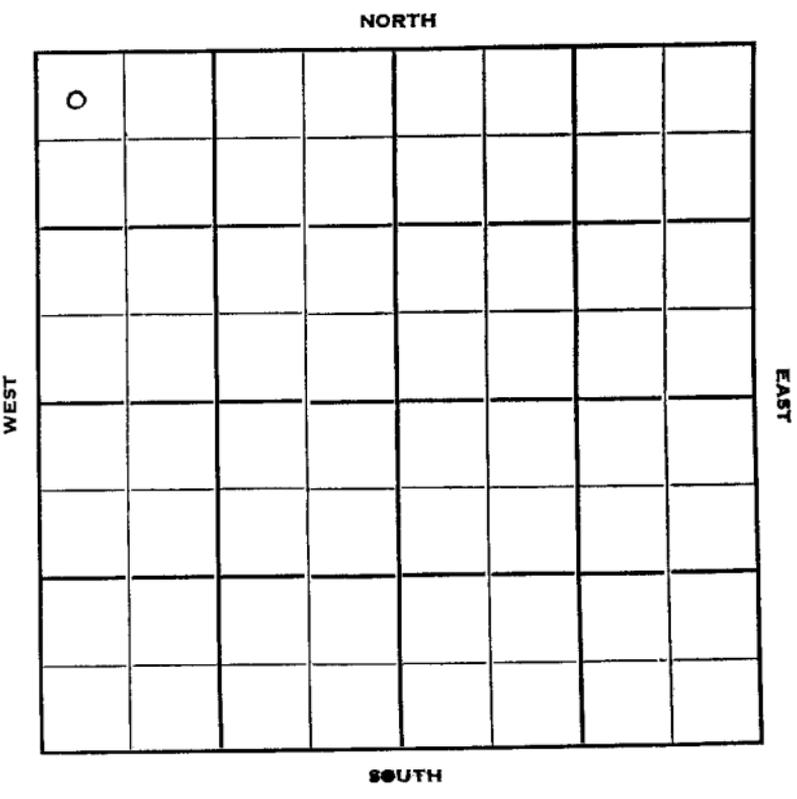

Pratt

KANSAS

Sec. 4 Twp. 29 R. 14 W

Well No. # 1 Luther Farm

Flynn Oil Company

Barbour Contractor


Wildcat

330 Ft. from N. Line

_____ Ft. from S. Line

_____ Ft. from E. Line

330 Ft. from W. Line

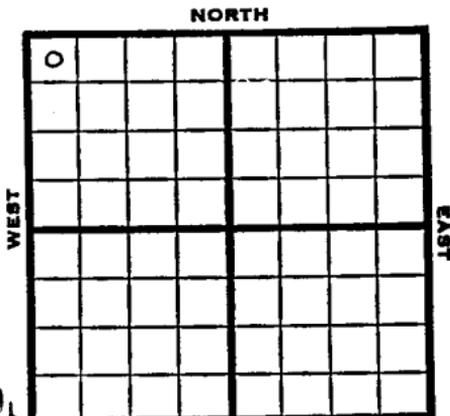

NW NW NW
MCPC has SE of 29-28-14
Cities Service ~~DM~~ & NW of 6-29-14

1951 Elev. 2022' REPORT

5/9 Location

5/29 Spud 5-9-51
D&A TD 4707
8" @ 315 Lans. 4025
DST 4199-4220 opn 45 min.
Rec. 40' so& gcm Cong. 4470'
Miss 4484 Kinderhook 4515-24
Viola 4524
DST 4511-60 opn 1/2 hr Rec. 80' mud
Simp. 4602-13
DST 4584-4613 opn 1/2 hr Rec. 10' mud
Arb. 4679 DST 4615-85 opn 1 hr
Rec. 30' mud TD 4707
D&A
ABANDONED

County **Pratt** State **Kansas**

Sec. **4** (Blk. Twp.) **29** (Sur. Rge.) **14W** Map No.

Operator **Flynn Oil**

Well No. **1** Farm **Luther**

Elev. Location **NW NW NW**

0					

FIRST REPORT

330 Ft. From **N** Line **NW**

330 Ft. From **W** Line Quarter

1st. Report **MAY 9 1951**

Completion

Remarks **Cities Service DHM**

Barbour - Contr.

Spudding Date

Drlg. Data **Wildcat**

MCPC has SE of 29-28-14 and NW of 6-29-14

Location **?**

J. E. TYRA

County Pratt State Kansas

Sec. 4 (Bk. 29 (Sur. 14W Map No.)
(Twp.) (Rge.)

Operator Flynn Oil

Well No. 1 Farm Luther

Elev. 2022 Location NW NW NW

0					

330 Ft. From N Line NW
330 Ft. From W Line Quarter

Ist. Report

Completion MAY 29 1951

Remarks Wildcat

Barbour - Contr.

Spudding Date 5-9-51

Drlg. Data D & A TD 4707

8" @ 315 Lans. 4025 DST 4199-4220

open 45 min. Rec. 40' so&rcm Cons. 4470

Miss. 4484 Kinderhook 4515-24 Viola 4524

DST 4511-60 open 1/2 hr. Rec. 80' mud

Simp. 4602-13 DST 4584-4613 open 1/2 hr.

Rec. 10' mud Arb. 4679 DST 4615-85

open 1 hr. Rec. 30' mud TD 4707

D & A

J. E. TYRA