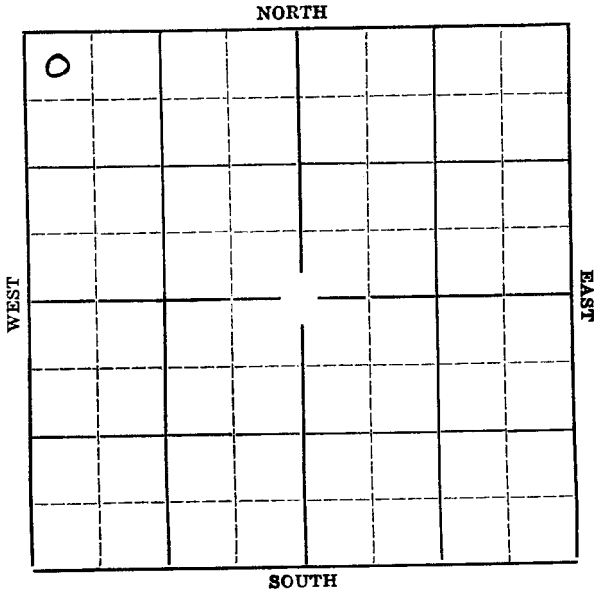
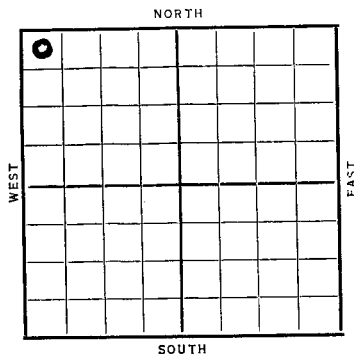


Section 4 Township 29 Range 2-WWell Number 1 KimelCompany Empire

Sec. 4 Twp. 29 R. 2-WWell No. #1 Kimel FarmEmpire Company330 Ft. from N. Line Ft. from S. Line Ft. from E. Line330 Ft. from W. LineSpecialDate
1937

REPORT

3/10 R O G3/18 Rig3/25 15" @ 102'. Drlg. 1000'.4/2 Lansing 2655'. Drlg. 2960'.4/8 Drlg. 3076'4/16 Chat 3648'. T.D. 3880' Fsg.4/23 Simpson 4094'. Coring 4102'.4/28 Simp. 4094'.

T.D. 4131'.

ABANDONED

KANSAS

Map No. 38 Sec. 4 Twp. 29 R. 2WWell No. 1 KimmelEmpire Company

Contractor

Special

330 Ft. from N. Line

_____ Ft. from S. Line

_____ Ft. from E. Line

230 Ft. from W. Line

SECTION PLAT

0			

FIRST REPORT

Location _____

Rig up _____

Drilling and Remarks:

ROY

RECORD

Cased _____ in., _____ ft

Sand _____

Gas _____

Oil _____

Total Depth _____

PRODUCTION

1st 24 hrs. Nat. _____

1st 24 hrs. after shot _____

Gas _____ Cu. Ft

Dry Hole _____

Abandoned _____

Date

JUL 23 1907 19

S. J. LEWIS Scout

KANSAS *Sedgwick*Map No. *38* Sec. *4* Twp. *29* R. *2W*Well No. *1 - Kinsel**Empire* Company

Contractor

ABANDONED*330* Ft. from N. Line

_____ Ft. from S. Line

_____ Ft. from E. Line

330 Ft. from W. Line**SECTION PLAT**

<i>0</i>			

Location _____

Rig up _____

Drilling and Remarks:

*D & A***RECORD**

Cased _____ in., _____ ft.

Sand *Simp - 4094*

Gas _____

Oil _____

Total Depth *4131***PRODUCTION**

1st 24 hrs. Nat. _____

1st 24 hrs. after shot _____

Gas _____ Cu. Ft.

Dry Hole _____

Abandoned _____

Date

APR 28 1937

19

R. D. Hatfield Scout