


Section 4 Township 29 Range 37W

Well No. #1 Sullivan

Company Hugoton Prod.

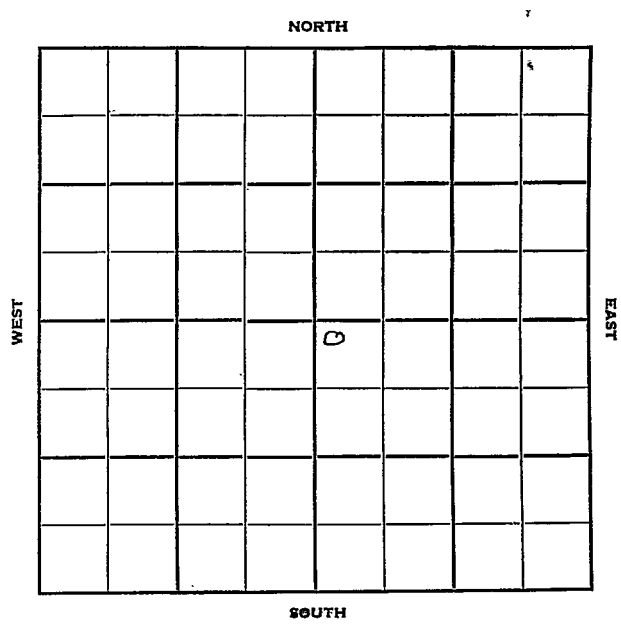

Grant

KANSAS

Sec. 4 Twp. 29 R. 37W

Well No. #1 Sullivan Farm

Hugoton Prod. Company

Contractor


100' Ft. from N. Line

Ft. from S. Line

Ft. from E. Line

100' Ft. from W. Line

NW NW SE

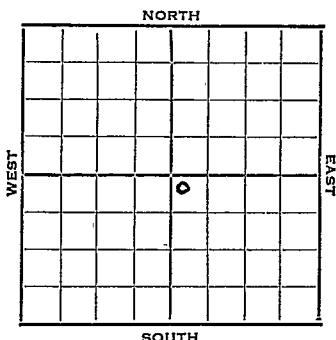

SOUTH

1952 Elev. 3026' REPORT

3/26 Spud 3-13-52
10" @ 512
RTD 3290
7" @ 2376

4/1 TD 2626' 260' of 5" liner 3000 A

4/9 NR

4/23 "

4/30 "

5/7 "

5/14 "

5/21 "

5/28 "


6/11 "

6/18 13,500 A

6/25 Spud 3-13-52
Gas Well TD 2626
10" @ 512 7" @ 2376 TD 2626
Hol. 2333 Her. 2374 Kri 2390-2452
Win. 2457 Ft. Riley 2524
13,500 A Comp. 23,584,000 gas

COMPLETED

County _____ Grant _____ State Kansas
 Sec. 4 (Blk. 29 (Sur. 37W Map No. _____
 (Twp.) (Rge.)
 Operator Hugoton Prod.
 Well No. 1 Farm Sullivan
 Elev. 3026 Location NW NW SE

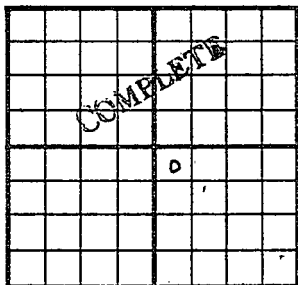

100 Ft. From N Line SE
100 Ft. From W Line Quarter
 Ist. Report _____
 Completion JUN 25 1952
 Remarks _____

Spudding Date 3-13-52

Drlg. Data Gas well TD 2626
10" @ 512 7" @ 2376 TD 2626
Hol. 2333 Her. 2374 Kri. 2390-2452
Win. 2457 Ft..Riley 2524 13500 A
Comp. 23,584,000 gas

J. G. McGEHEE