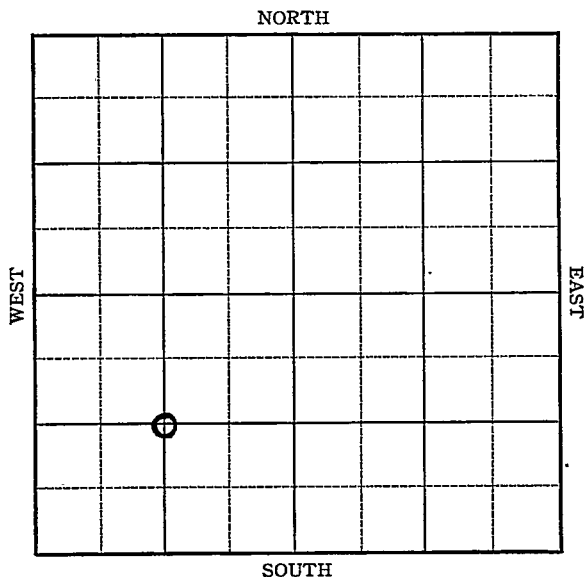


Section 4 Township 29 Range 36-WWell No. 1 - MaxwellCompany Columbian Fuel

Grant

Map No. *No Map* Sec. *4* Twp. *29* R. *26^W*

Well No. *1 - Maxwell*

Columbian Fuel Company

Contractor

FIRST REPORT

SECTION PLAT

_____ Ft. from N. Line

1320 Ft. from S. Line

_____ Ft. from E. Line

1320 Ft. from W. Line

Location _____

Rig up _____

Drilling and Remarks:

R. U. R.

RECORD

Cased _____ in., _____ ft.

Sand _____

Gas _____

Oil _____

Total Depth _____

PRODUCTION

1st 24 hrs. Nat. _____

1st 24 hrs. after shot _____

Gas _____ Cu. Ft.

Dry Hole _____

Abandoned _____

Date

JUN 9 1937

19

H. D. Hatfield


Scout

Map No. No Map Sec. 4 Twp. 29 R. 36 WWell No. 1 - MaxwellColumbian Company

Contractor

COMPLETED

SECTION PLAT

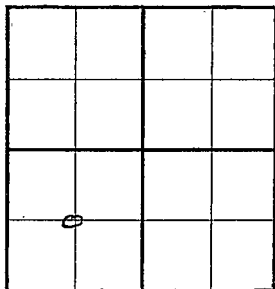

_____ Ft. from N. Line

1320 Ft. from S. Line

_____ Ft. from E. Line

1320 Ft. from W. Line

Location _____

Rig up _____

Drilling and Remarks:

50 gtsProd - 6 1/2 M gas

RECORD

Cased 8 in., 2462 ft.Sand 2462

Gas _____

Oil _____

Total Depth 2724

PRODUCTION

1st 24 hrs. Nat. _____

1st 24 hrs. after shot _____

Gas _____ Cu. Ft.

Dry Hole _____

Abandoned _____

Date

JUL 14 1937H. D. Hatfield Scout