

KANSAS


Pratt

FORM 51 5M PETROL

Section 5 Township 29 Range 13W

Well No. 1 J. H. Shaw

Company Sinclair-Prairie

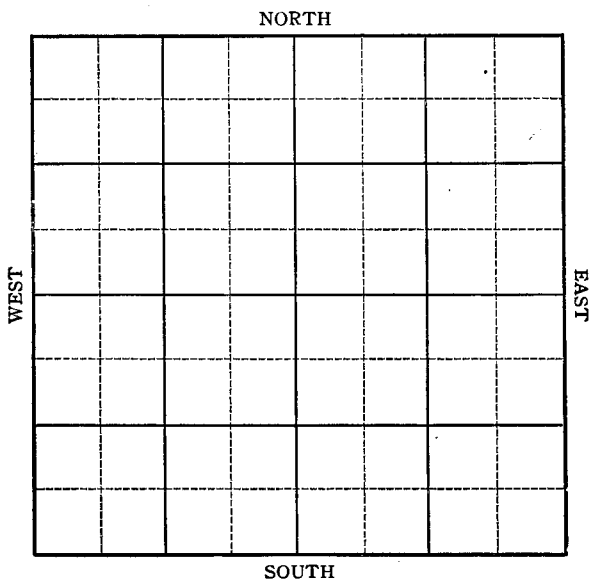

Sec. 5 Twp. 29 S R. 13 W

Well No. #1 J. H. Shaw Farm

SINCLAIR-PRAIRIE Company

Ludwig


990' Ft. from N. Line

Ft. from S. Line

330' Ft. from E. Line

Ft. from W. Line

SE NE NE Elev. 1841

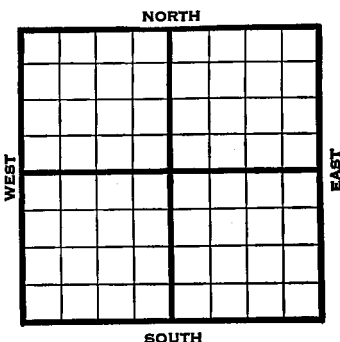

945

REPORT

-18	RUR	
4/27	"	
5/3	10" @ 439	
	Drlg. 1700'	
5/10	Drlg. 2940'	
5/17	Drlg. 3915	
5/24	Lans	3925
	Drlg. 4370'	
5/31	Miss 4375	
	Viola 4400	
	Simp Sh 4499	
	Simp Sd 4511	
	Drlg.	
6/8	Arb. 4617	TD 4625
6/20	Arb. 4612	
	5" @ 4614'	
	TD 4622'	

ABANDONED

Kansas Pool Name LudwigMap No. _____ Sec. 5 Twp. 29 R. 13WWell No. 1 J. H. ShawSinclair-Prairie

Company


ABANDONED

Contractor

SE NE NE

E. 11941

SECTION PLAT

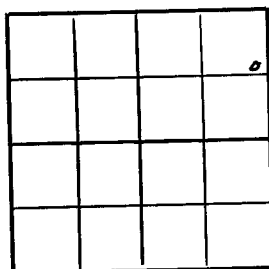990 Ft. from N. Line

_____ Ft. from S. Line

330 Ft. from E. Line

_____ Ft. from W. Line

Pratt County

Location _____

Rig up _____

Drilling and Remarks:

Cor 84612
5" @ 4614

RECORD

Cased _____ in., _____ ft.

Sand _____

Gas _____

Oil _____

Total Depth 4622**PRODUCTION**

1st 24 hrs. Nat. _____

1st 24 hrs. after shot _____

Gas _____ Cu. Ft.

Dry Hole _____

Abandoned _____

Date

JUN 20 1945 19S. J. LEWIS Scout

Kansas Pool Name LudwigMap No. 92 Sec. 5 Twp. 29 R. 13WWell No. 1 J. H. ShawSinclair-Prairie Company

FIRST REPORT

Contractor

SE NE NE

SECTION PLAT

			o

990 Ft. from N. Line Ft. from S. Line330 Ft. from E. Line Ft. from W. LinePrattLocation Rig up

Drilling and Remarks:

RUR

RECORD

Cased in., ft.Sand Gas Oil Total Depth

PRODUCTION

1st 24 hrs. Nat. 1st 24 hrs. after shot Gas Cu. Ft.Dry Hole Abandoned

Date

APR 1 8 1945

19

S. J. LEWIS Scout