


Section 5 Township 29 Range 13W

Well No. #1 Hertlein

Company Rine Drlg. et al

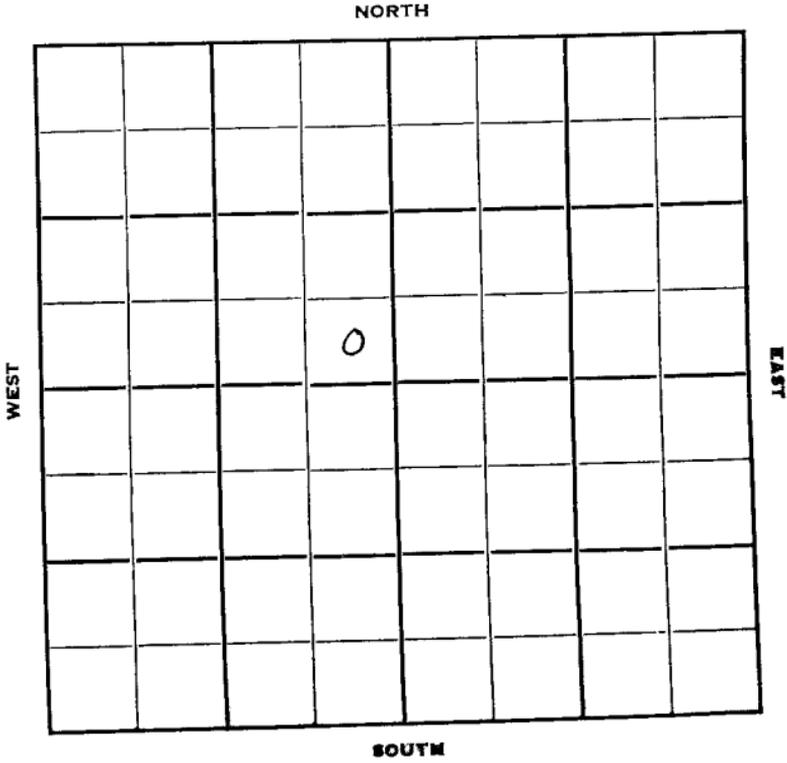

Sec. 5 Twp. 29 R. 13-W ✓

Well No. #1 Hertlein Farm

Rine Drlg. etal Company

Rine Drlg. Contractor

Wildcat


_____ Ft. from N. Line

330 Ft. from S. Line

330 Ft. from E. Line

_____ Ft. from W. Line

SE SE NW

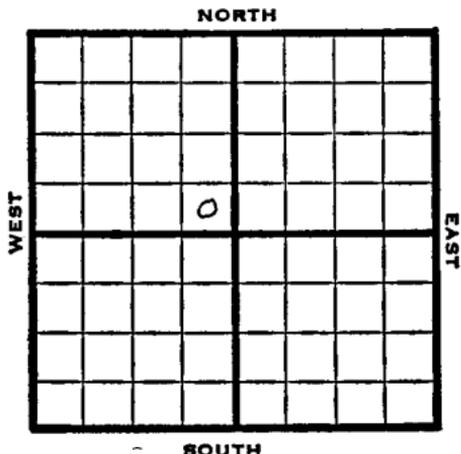

| 1950 | Elev 1953 | REPORT |
|-------|---------------|--------------------------|
| 10/18 | Drlg | |
| 11/1 | Spud 10-12-50 | |
| | 10" @ 331 | |
| | Lans 3950 | Miss 4429 |
| | Simp 4518 | Dol 4531 |
| | DST 4534-50 | opn 1 hr rec 1400' water |
| | Simp sd 4540 | Arb 4634 |
| | TD 4653 | |
| | D&A | |
| | ABANDONED | |


County **Pratt** State **Kansas**

Sec. **5** (Blk. Twp.) **29** (Sur. Rge.) **13W** Map No.

Operator **Rine Drlg. etal.**

Well No. **1** Farm **Hertlein**

Elev. Location **SE SE ~~SW~~ NW**

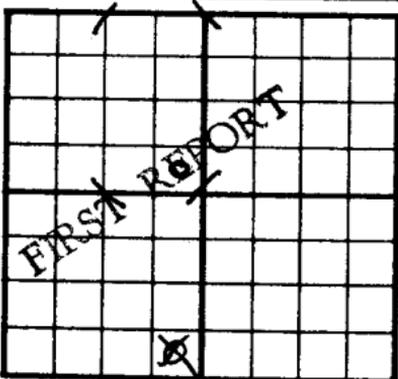

330 Ft. From **S** Line **SW**

330 Ft. From **E** Line Quarter

1st. Report **JCT 1 8 1950**

Completion

Remarks

Rine Drlg. - Contr.

Spudding Date

Drlg. Data **Wildcat**

drlg.


County Pratt State Kansas

Sec. 5 (Blk. 29 (Sur. 13W (Twp. Rge.) Map No.

Operator Rine Drls. etal.

Well No. 1 Farm Hertlein

Elev. 1953 Location SE SE 1/4

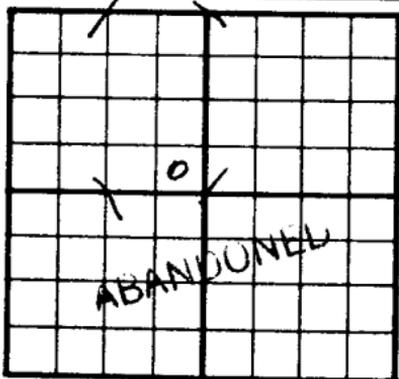

330 Ft. From S Line NW

330 Ft. From E Line Quarter

Ist. Report

Completion NOV 1 1950

Remarks Wildcat

Rine Drls. - Contr.

Spudding Date 10-12-50

Drig. Data D & A TD 4653

10" C. 331 Lans. 3950 Fiss. 4429

Simp. 4518 Dol. 4531 DST 4534-50

open 1 hr. Rec. 1400' water Simp. sd.

4540 Arb. 4634 TD 4653

D & A