


Pratt

KANSAS

SECTION 5 TOWNSHIP 29 RANGE 14W

WELL NO. #1 Jenkins

COMPANY Aurora & Graybol Oil

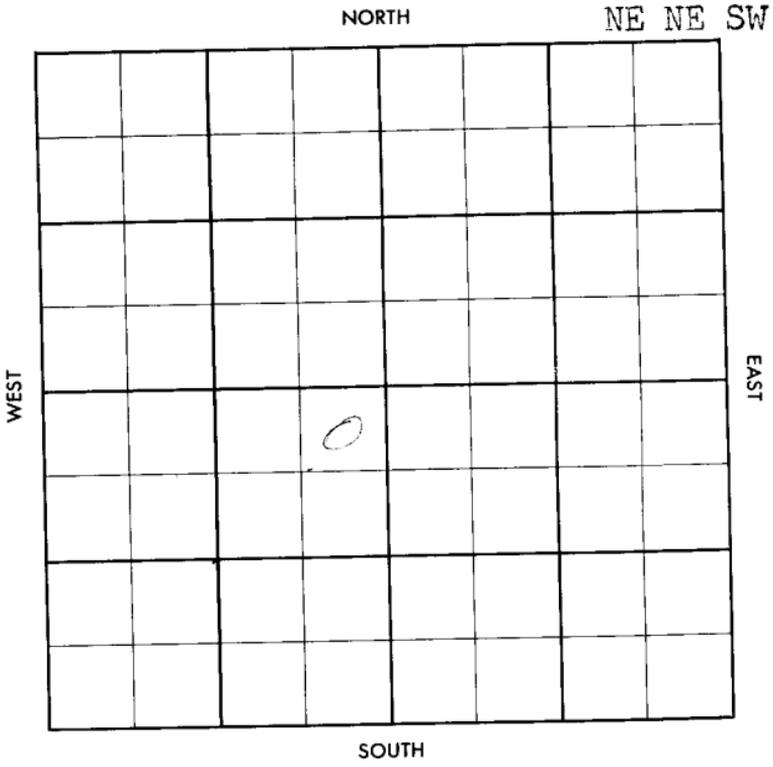

WILDCAT

ORM 513 SUNNY

County Pratt Elev. _____
 Sec. 5 Twp. 29 Rge. 14W
 Company Aurora & Graybol Oil
 Farm Name Jenkins No. 1

TOPS	DEPTH	LOG	DATE	Loc. in Sec.
Anh.				NE NE SW
Tr.				
H.				
Tr.				
Dg.				
Bl.				
L.				
K.C.				
B.K.C.				
Ce.				
C.				Graybol Tools
M.				
M.				
K.				
Mz.				
Me.				Wildcat
V.				
S.				
S.				
A.				
R.				
PE.				
G.				
TD.				

Geol. _____
 Contr. _____
Graybol Tools
 Pool
Wildcat

FIRST REPORT
 APR 24 57

Date Comm. Phillips (DHM)
 Location _____

Co.
No.
Sec.
T.
R.

County Pratt Elev. 2029
 Sec. 5 Twp. 29 Rge. 14W
 Company Aurora & Graybol Oil
 Farm Name Jenkins No. 1

TOPS	DEPTH	LOG	DATUM
Anh			
TP			
H.	3855	3853	
Tr.		3874	
Dg.	3906	4019	
Bl.	4021	4033	
L.	4045	4033	
K.C.			
B.K.C.			
Ce.			
C.			
M.	4503	4502	
M.			
K.			
Mz.			
Mo.			
V.	4537	4533	
S. <i>sb</i>	4647	4637	
S.			
A.	4735	4733	
R.			
PE.			
G.			
TD	4770		

Loc. in Sec. NE NE SW
 Geol. _____
 Contr. _____
 Graybol Tool _____
 Pool _____
 Wildcat _____

ABANDONED
 MAY 22 1957

Date Comm. Phillips (DNE)
 Location MAY 1 57 4-25-57 858
278/200 @ 2639 Trip
@ 4113 MAY 15 57 DST 4199-4236
1 hr rec 40' 50 CM BHP
705/20" DST 4244-94 hr
1 hr rec 290' SW FP 90-195
BHP 1498/20" DST 4500-59
hr 30" rec 20' Md. All press 0
DST 4562-4621 1 hr 2250'

Gas rec 75' 50 E' 6 CM FP
85-85 BHP 330/20" W
4680 W 2257

DEW