


Section 5 Township 29 Range KANSAS 32 W
Well No. # 1 Becker
Company Kansas Natural Gas

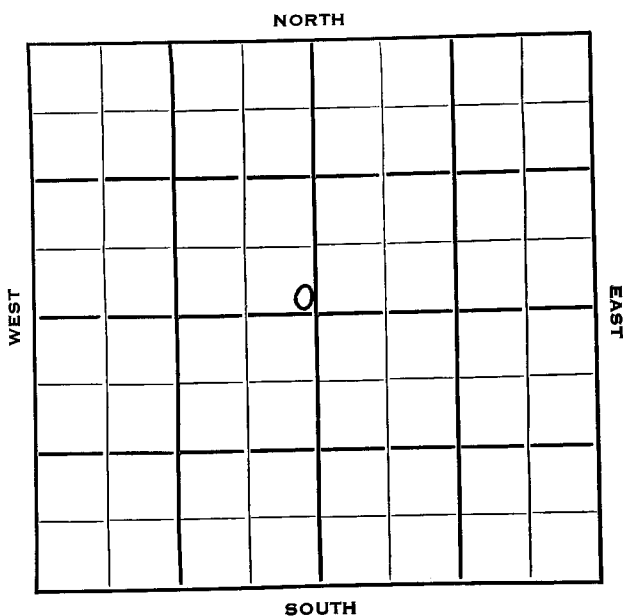

Haskell

SEC.	TWP.	R.
5	29	KANSAS 32W

WELL NO.

#1 Becker

FARM

COMPANY

Kansas Natural Gas

CONTRACTOR

Hugoton Pool

Ft. from N. Line


150

Ft. from S. Line

150

Ft. from E. Line

Ft. from W. Line

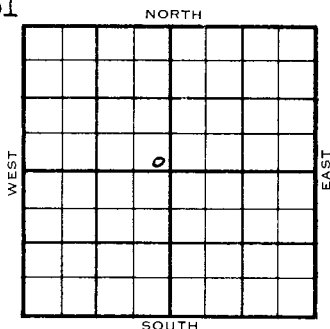

SE SE NW

1953	ELEVATION	REPORT
	2917'	

11/24 Location
 12/30 Spud 11-22-53
 Gas Well
 TD 2720'
 10" @ 588'
 Her. 2628', Kri 2650', Win 2702'
 7" @ 2703'
 TD 2704
 6/2694-95, DD 2720, 3000A
 PB 2684, 108/2658-76, 4000A, gas & wt
 Comp. 1,150,000 cfigpd 100 gwph

COMPLETED

County Haskell State Kansas

Sec. 5 (Blk. 29) (Sur. 32W) Map No. _____

Operator Kansas Natural Gas

Well No. 1 Farm Becker

Elev.	Location	SE	SE	NE
-------	----------	----	----	----

0

FIRST REPORT

150 Ft. From S Line NT

150 Ft. From F Line Quarter

1st. Report NOV 24 1952

Completion

Remarks

Spudding Date

Drig. Data Hugoton Pool

Location

J. G. McGEHEE

County Haskell State Kansas

Sec. 5 (Blk. Twp.) 29 (Sur. Rge.) 32W Map No.

Operator Kansas Natural Gas

Well No. 1 Farm Becker

Elev.	2917	Location	SE SE NW
-------	------	----------	----------

COMPLETE

150 Ft. From S Line NW

150 Ft. From E Line Quarter

1st. Report

Completion DEC 20 1953

Remarks	Hugoton Pool
---------	--------------

Spudding Date 11-22-53

Drlg. Data Gas well TD 2720

10" @ 588 Her. 2628 Kri. 2650

Win. 2702 7" @ 2703 TD 2704

6/ 2694-95 DD 2720 3000 A PB 2684

108/ 2658-76 4000 A gas & wtr.

Comp. 1,150,000 cf gpd 100 gwph

J. G. McGEEHAY