

- KANSAS


FORM 51 5M 6-46 PETROL

Grant county

Section ~~3~~ 5 Township 29 Range 38-W

Well No. #1, ~~in 61 acre~~ Mc GANNON

Company Stanolind Oil and Gas Company

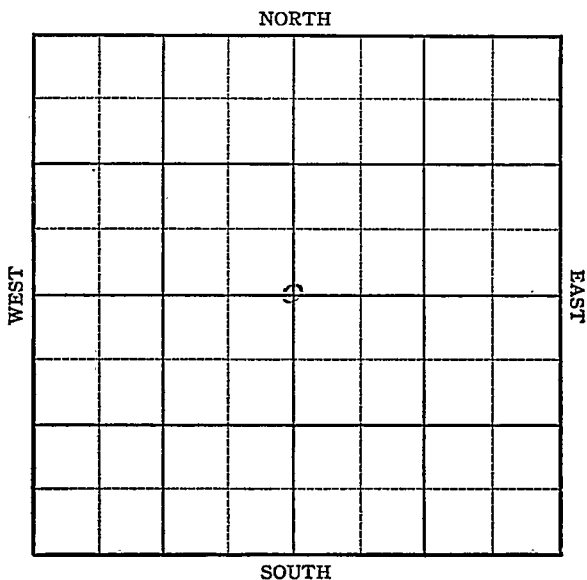

KANSAS


Grant ✓

Sec. 5 Twp. 29 R. 38WWell No. 1 McClaren #1 McGannon Farm
Stanobind Company

Hugoton

2640 Ft. from N. Line Ft. from S. Line2640 Ft. from E. Line Ft. from W. Line

C Sec.

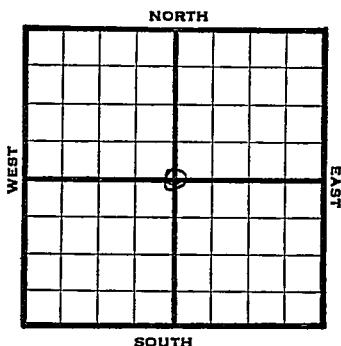

1946 Elev. 3122' REPORT

11/27 Drlg 512'
12/3 8" @ 618' WOC
12/10 2566 fsg

1947

1/2 5" @ 2528'
TD 2580'
Perf
18000 Acid
9,205,000 Gas
425# RPR

COMPLETED

Map No. _____ Sec. 9 Twp. 29 R. 38W

Well No. 1 McClaren

Stanolind Company

-IRST REPORT Contractor

C Sec.


SECTION PLAT

2640 Ft. from N. Line

_____ Ft. from S. Line

2640 Ft. from E. Line

_____ Ft. from W. Line

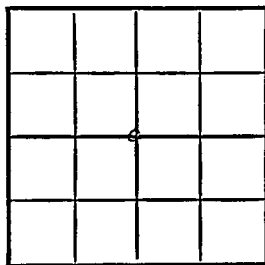

Grant County

Location _____

Rig up _____

Drilling and Remarks:

drlg. 512

RECORD

Cased _____ in., _____ ft.

Sand _____

Gas _____

Oil _____

Total Depth _____

PRODUCTION

1st 24 hrs. Nat. _____

1st 24 hrs. after shot _____

Gas _____ Cu. Ft.

Dry Hole _____

Abandoned _____

Date

NOV 27 1946 19

S. J. LEWIS Scout

Map No. _____ Sec. 5 Twp. 29 R. 38W

Well No. 1 McGannon

Stanolind

Company

CORRECTION

Contractor

C Sec.


SECTION PLAT

2640 Ft. from N. Line

_____ Ft. from S. Line

2640 Ft. from E. Line

_____ Ft. from W. Line

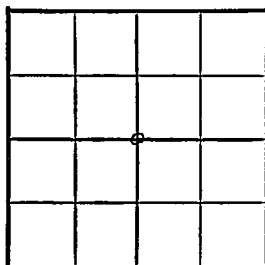

Grant County

Location _____

Rig up _____

Drilling and Remarks:

Reported
#1 McClaren
9-29-38W

RECORD

Cased _____ in., _____ ft.

Sand _____

Gas _____

Oil _____

Total Depth _____

PRODUCTION

1st 24 hrs. Nat. _____

1st 24 hrs. after shot _____

Gas _____ Cu. Ft.

Dry Hole _____

Abandoned _____

Date

DEC 1 1 1946 19

S. J. LEWIS

Scout

Kansas

KANSAS

Hugoton Pool

Map No. _____ Sec. 5 Twp. 29 R. 38WWell No. 1 McGannon

Stanolind

Company

COMPLETED

Contractor

C Sec.

E/3122
SECTION PLAT2640 Ft. from N. Line

_____ Ft. from S. Line

2640 Ft. from E. Line

_____ Ft. from W. Line

Grant County

Location _____

Rig up _____

Drilling and Remarks:

*51102538**Perf.**18000 acid**9,205,000 Gas**425# R/P*

RECORD

Cased _____ in., _____ ft.

Sand _____

Gas _____

Oil _____

Total Depth 2580

PRODUCTION

1st 24 hrs. Nat. _____

1st 24 hrs. after shot _____

Gas _____ Cu. Ft.

Dry Hole _____

Abandoned _____

Date

JAN 2 1947 19

S. J. LEWIS

Scout