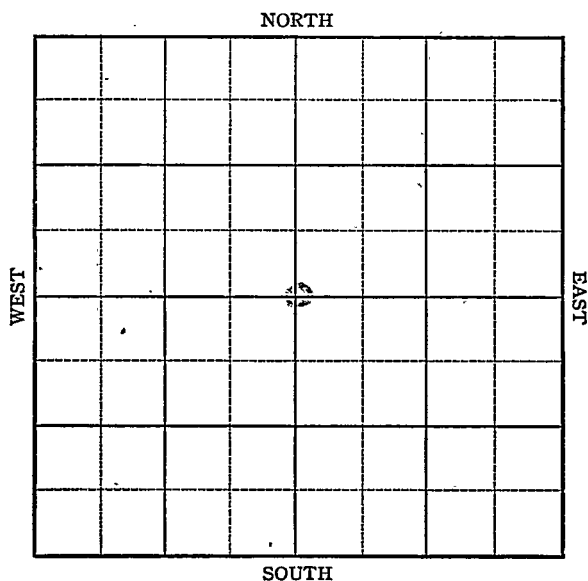


KANSAS

FORM 51 5M 6-46 PETROL

Stanton county

Section 5 Township 29 Range 39-WWell No. #1, DavisCompany Stanolind Oil and Gas Company

KANSAS

Stanton county ✓

Sec. 5 Twp. 29 R. 39-WWell No. #1, Davis FarmStanolind Oil and Gas Company

Hugoton Pool


2640' Ft. from N. Line

Ft. from S. Line

2640' Ft. from E. Line

Ft. from W. Line

C Sec.

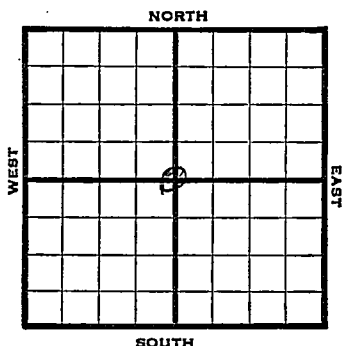

1946

REPORT

10/30	10" @ 609'
	Drlg. 2125'.
11/6	TD 2515, .
	5" @ 2492, RUST
11/12	" "
11/20	" "
11/27	TD 2525'
	114 shots 2447-66
	8000 acid
12/3	138 shots 2378-2408'
	500 acid
12/11	5" @ 2492'
	TD 2525'
	Perf
	20000 Acid
	4,850,000 Gas

COMPLETED

Map No. _____ Sec. 5 Twp. 29 R. 39WWell No. 1 Davis

_____ Stanolind _____ Company

FIRST REPORT

_____ Contractor

C Sec.


SECTION PLAT

2640 Ft. from N. Line

_____ Ft. from S. Line

2640 Ft. from E. Line

_____ Ft. from W. Line

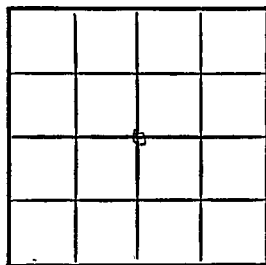

Stanton County

Location _____

Rig up _____

Drilling and Remarks:

10" @ 609drlg. 2125'

RECORD

Cased _____ in., _____ ft.

Sand _____

Gas _____

Oil _____

Total Depth _____

PRODUCTION

1st 24 hrs. Nat. _____

1st 24 hrs. after shot _____

Gas _____ Cu. Ft.

• Dry Hole _____

Abandoned _____

Date

OCT 30 194619S. J. LEWISScout

Kansas

Map No. _____ Sec. 5 Twp. 29 R. 30WWell No. 1 Davis

Stanolind _____ Company

COMPLETED

Contractor


C Sec.

E1,3208
SECTION PLAT2640 Ft. from N. Line

_____ Ft. from S. Line

2640 Ft. from E. Line

_____ Ft. from W. Line

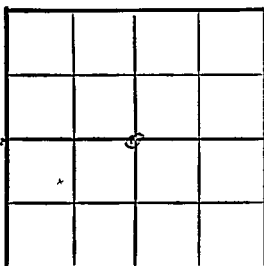

Stanton County

Location _____

Rig up _____

Drilling and Remarks:

*5" @ 24 ft**Perf**20000 acw**4,650,000 lbs***RECORD**

Cased _____ in., _____ ft.

Sand _____

Gas _____

Oil _____

Total Depth 2625**PRODUCTION**

1st 24 hrs. Nat. _____

1st 24 hrs. after shot _____

Gas _____ Cu. Ft.

Dry Hole _____

Abandoned _____

Date

DEC 1 1 1946 19

S. J. LEWIS Scout