


Pratt

Section 6 Township 29 Range 12-W

Well No. #1 Green

Company Shell Oil

NORTH Wildcat

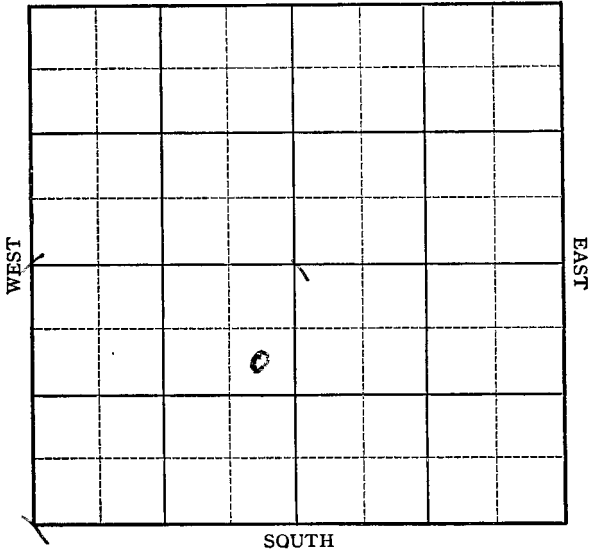

194E
5/C


194E. 4730'
T.D. 4730'
No shows.

APR 11 1948

Map No. 54 Sec. 6 Twp. 29 R. 12WWell No. 1 GreenShell Oil Company**FIRST REPORT**

Contractor

SE NE SW

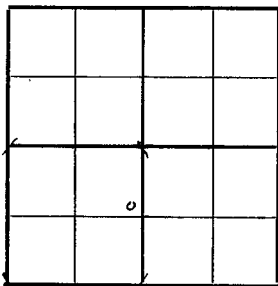990 Ft. from N. Line Ft. from S. Line330 Ft. from E. Line Ft. from W. Line**SECTION PLAT**

WILDCAT

Location _____

Rig up _____

Drilling and Remarks:

Rotary

RECORD

Cased _____ in., _____ ft.

Sand _____

Gas _____

Oil _____

Total Depth _____

PRODUCTION

1st 24 hrs. Nat. _____

1st 24 hrs. after shot _____

Gas _____ Cu. Ft.

Dry Hole _____

Abandoned _____

Date

MAR 1 8 1942 19S. J. LEWIS

Scout

