

FORM 51


Kingman

KANSAS

Section 6 Township 29 Range 5W

Well No. #1 Moorhouse

Company Magnolia Petroleum Company

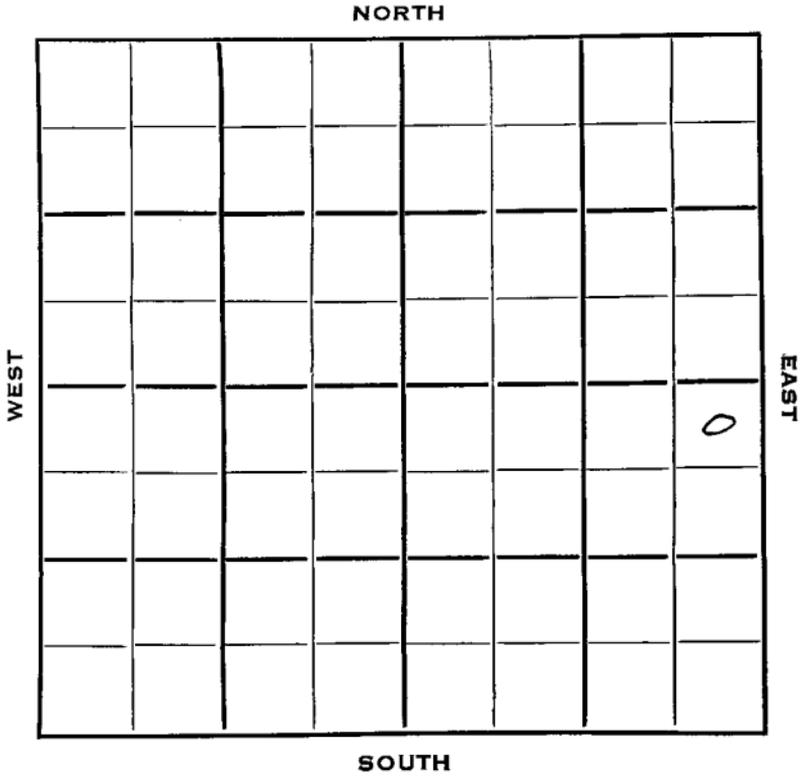

Sec. 6 Twp. 29 R. 5 W

Well No. # 1 Moorhouse Farm

Magnolia Pet. Company

Barnett Drlg. Contractor

Wildcat

330 Ft. from N. Line


Ft. from S. Line

330 Ft. from E. Line

Ft. from W. Line

NE NE SE

CSO - support

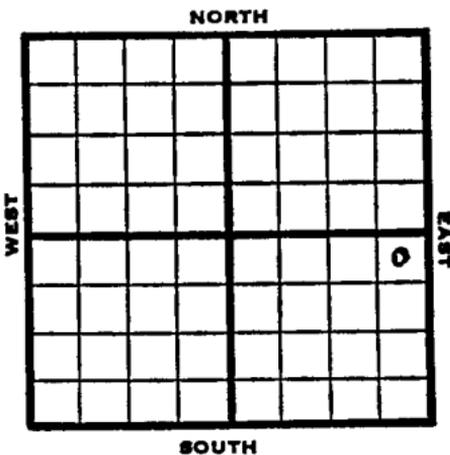

1953 Elev. 1401' REPORT

3/25 Spud 3-21-53
13" @ 158
Drlg. 1100'

4/2 Lans 3124
Drlg 3200'

4/9 DST 3392-3441, 1 hr., 75' M, 1290#
Miss 3879
DST 3880-3915, 1 hr., 570' SW,
1280#
Drlg. 4008'

4/15 Spud 3-21-53
D & A
TD 4432'
13" @ 158'
Lans 3124,
DST 3392-3441 open 1 hr, rec 75' mud
1290# Miss 3879
DST 3880-3915 open 1 hr. Rec 570' sw
1280# Kh. 4128, Viola 4240
DST 4241-47 open 1 hr, rec 15' mud,
33#
DST 4244-54 open 1 hr. Rec 10' mud,
52# Simp 4267, Arb 4382
TD 4432
D & A

ABANDONED

