
FORM 51 25M 8-50 WESTERN Kingman KANSAS

Section 6 Township 29 Range 5W

Well No. #1 Morehouse (Moorhouse)

Company E. F. Wakefield

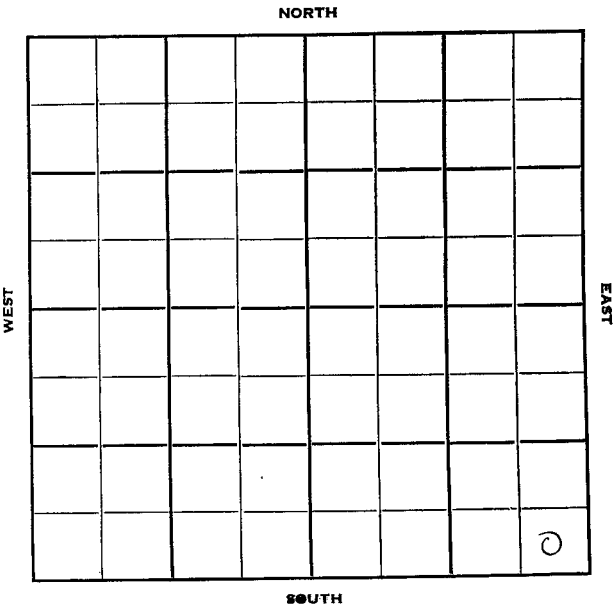

FORM 252-B
10M 11-50 PETROL

Kingman

Sec. 6 Twp. 29 R. 5W

Well No. #1 Morehouse Farm

E. F. Wakefield Company

Contractor

Wildcat


Ft. from N. Line

330' Ft. from S. Line

330' Ft. from E. Line

Ft. from W. Line

SE SE SE

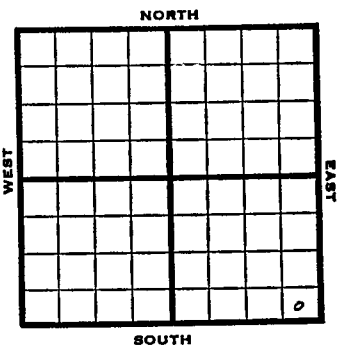

1951	Elev. 1408' REPORT
6/13	Surf. Set
8/1	Spud 7-3-51 D&A TD 4439 8" @ 102 Br Lime 3037 Lans. 3052 Miss 3900 Kh. 4130 Misenor 4228 Viola 4256 Simp 4274 Arb. 4389 TD 4439 D&A

ABANDONED

FORM 275 FOR SALE BY KANSAS BLUE PRINT CO


County Kingman State Kansas

Sec. 6 (Blk. Twp.) 29 (Sur. Rge.) 5W Map No.

Operator E. F. Wakefield

Well No. 1 Farm Morehouse

Elev. Location SE SE SE

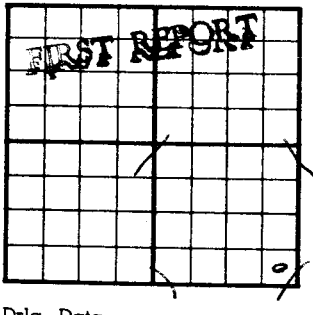

330 Ft. From S Line SE

330 Ft. From E Line Quarter

1st. Report JUN 13 1954

Completion

Remarks

Magnolia - P.O.

Spudding Date

Drlg. Data

Surf. Set Wildcat

J. E. TYRA

FORM 275 FOR SALE BY KANSAS BLUE PRINT CO.


County Kingman State Kansas

Sec. 6 (Blk. Twp.) 29 (Sur. Rge.) 5W Map No.

Operator E. F. Wakefield

Well No. 1 Farm Moorehouse

Elev. 1408 Location SE SE SE

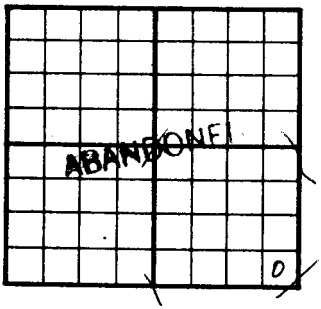

330 Ft. From S Line SE

330 Ft. From E Line Quarter

1st. Report

Completion AUG 1 1951

Remarks Wildcat

Spudding Date 7-3-51

Drlg. Data D & A TD 4439

8" @ 102 Br. lime 3037 Lans. 3052

Miss. 3900 Kh. 4130 Misenor 4228

Viola 4256 Simp. 4274 Arb. 4389

TD 4439 D & A

J. E. TYRA