


Section 6 Township 29 Range 32-W

Well No. #1 Watkins

Company National Assoc. Pet.

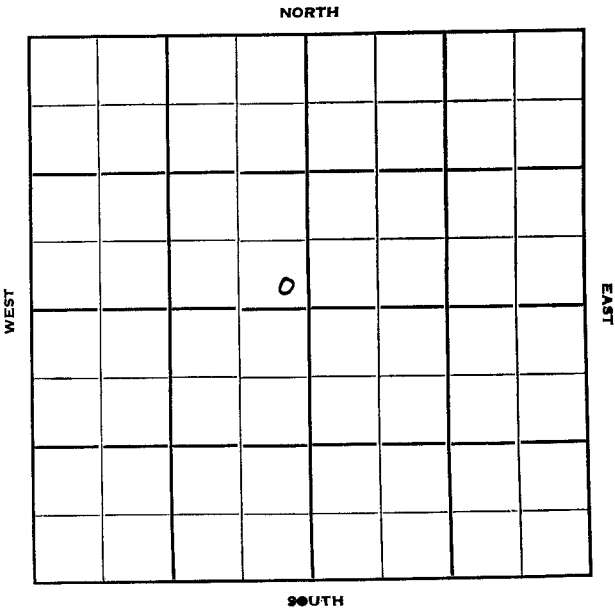

Haskell

Sec. 6 Twp. 29 R. 32W ✓


Well No. #1 Watkins Farm

National Assoc. Pet. Company

Contractor

Hugoton Pool

Ft. from N. Line

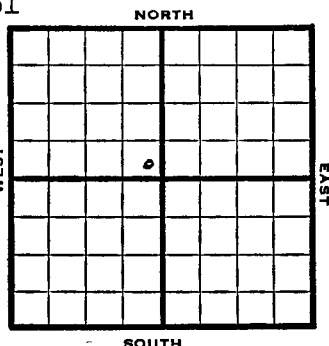

100' Ft. from S. Line

100' Ft. from E. Line

Ft. from W. Line

SE NW


1950 Elev. 2930' REPORT

11/15 Location

1951

2/21 Spud 11-24-50
Gas Well TD 2740
8" @ 611 5" @ 2722
TD 2740 Mer. 2648
Krider 2665' Win. 2720
276/2650-96 13,000 A
Comp. 7,635,000 gas 360#

COMPLETED

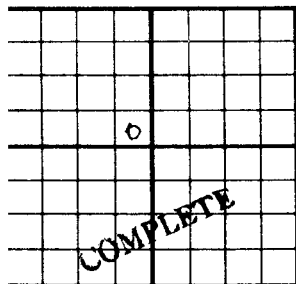County Haskell State KansasSec. 6 (Blk. Twp.) 29 (Sur. Rge.) 32W Map No.Operator National Assoc. Pet.Well No. 1 Farm WatkinsElev. 2930 Location SE NW100 Ft. From S Line NW100 Ft. From E Line Quarter

1st. Report

Completion FEB 21 1951Remarks Hugoton PoolSpudding Date 11-24-50Orig. Data Gas well TD 27408" @ 611 5" @ 2722 TD 2740Her. 2648 Krider 2665 Win. 2720276/ 2650-96 13000 AComp. 7,635,000 gas 360#