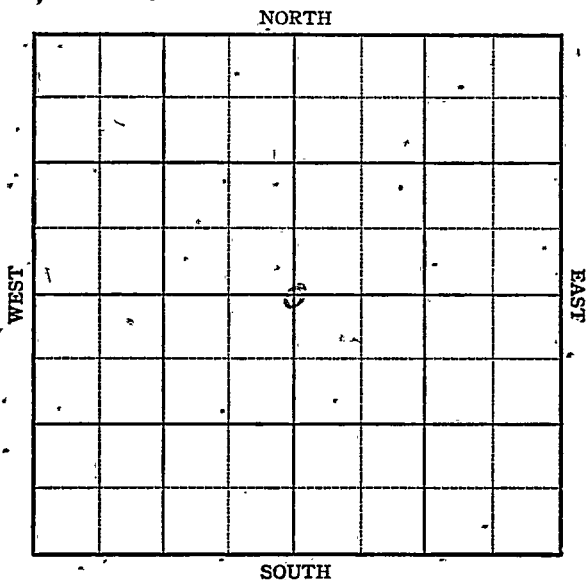


KANSAS

Grant county

Section 6 Township 29 Range 38-WWell No. #1, Federal Land Bank "E"Company Stanolind O&G Company

KANSAS

Grant County

Sec. 6 Twp. 29 R. 38W

Well No. 1 Federal Land Bank "E" Farm
Stanolind Company

Hugoton Pool


NORTH

2640 Ft. from N. Line

Ft. from S. Line

2640 Ft. from E. Line

Ft. from W. Line

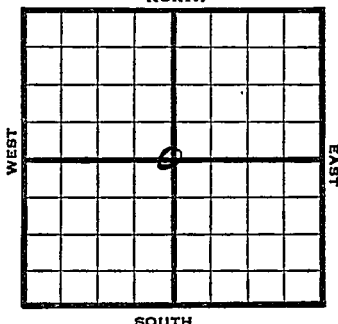

SOUTH

C. Sec.

1947 Elev. 3127' REPORT

1/2	8" @ 650'
	Drlg 198'
1/8	TD 2540'
	5" @ 2518', RUST
1/15	132 shots 2332-54
	180 " 2357-77
	210 " 2394-2429
	180 " 2473-93
	14000 Acid
1/21	" " "
1/30	" " "
2/5	" " "
2/12	" " "
2/19	" " "
2/26	5" @ 2518'
	Perf 14,000 Acid
	10 M Gas
	398 $\frac{1}{2}$ R Pr
	TD 2540'

COMPLETED

Map No. _____ Sec. 6 _____ Twp. 29 _____ R. 38W

Well No. 1 Federal Land Bank "E"


Stanolind _____ Company

FIRST REPORT

Contractor

C Sec.

SECTION PLAT

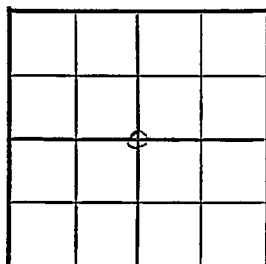

2640 Ft. from N. Line

_____ Ft. from S. Line

2640 Ft. from E. Line

_____ Ft. from W. Line

Grant County

Location _____

Rig up _____

Drilling and Remarks:

8" @ 650

drlg. 1981

RECORD

Cased _____ in. _____ ft.

Sand _____

Gas _____

Oil _____

Total Depth _____

PRODUCTION

1st 24 hrs. Nat. _____

1st 24 hrs. after shot _____

Gas _____ Cu. Ft.

Dry Hole _____

Abandoned _____

Date

JAN 2 1947

19

S. J. LEWIS

Scout

Map No. _____ Sec. 6 Twp. 29 R. 38W

Well No. 1 Federal Land Bank "E"

Stanolind Company

COMPLETE

Contractor

C Sec.


E 13127
SECTION PLAT

2640 Ft. from N. Line

_____ Ft. from S. Line

2640 Ft. from E. Line

_____ Ft. from W. Line

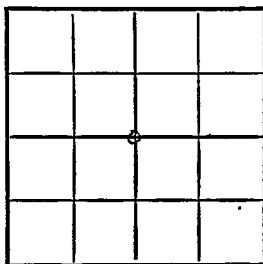

Grant County

Location _____

Rig up _____

Drilling and Remarks:

5' @ 25 ft.

*Perf
14000 acut
10 M. Sec*

898# R/R

RECORD

Cased _____ in., _____ ft.

Sand _____

Gas _____

Oil _____

Total Depth 2540

PRODUCTION

1st 24 hrs. Nat. _____

1st 24 hrs. after shot _____

Gas _____ Cu. Ft.

Dry Hole _____

Abandoned _____

Date

FEB 26 1947

19

S. J. LEWIS

Scout