


Haskell KANSAS

Section 6 Township 29 Range 33W

Well No. #1 Wheatley

Company United Prod.

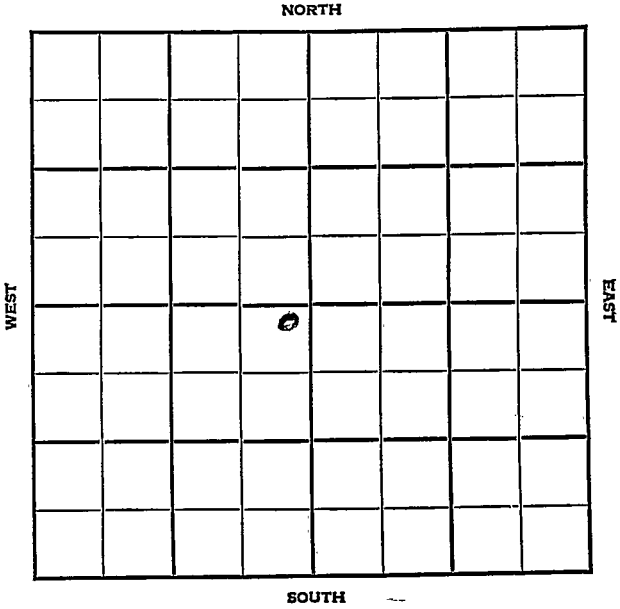

KANSAS

Haskell



Sec. 6 Twp. 29 R. 33W

Well No. #1 Wheatley Farm \_\_\_\_\_  
 United Prod. \_\_\_\_\_ Company

Hugoton Pool


100 Ft. from N. Line

\_\_\_\_\_ Ft. from S. Line

100 Ft. from E. Line

\_\_\_\_\_ Ft. from W. Line

NE SW

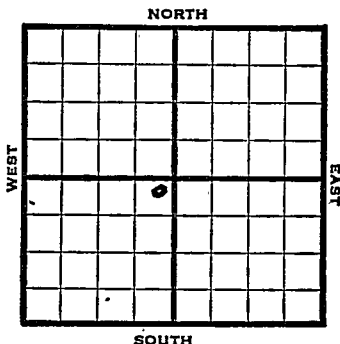

1947

Elev. 3005' REPORT

10/8

Location

10/15

"

10/22

10" @ 685'  
 Drlg. 2045'

10/29

Drlg. 2600'

11/5

Fishing 2600

11/12

Whipstock @ 2575'

11/19

TD 2602'  
 7" @ 2601'

11/25

"

12/3

TD 2762' - 2000 acid.

12/10

"

12/17

"

12/30

"

1948

1/7

"

1/14

TD 2763'  
 186' of 5" Perf liner @ 2763'

1/21

"

1/26

"

OVER

1948

2/4 2000 acid.

2/11 4000 acid.

2/18 "

2/25 2000 acid.

3/3 "

3/10 "

3/17 "

3/24 "

3/31 7" @ 2601'

186' of 5" Perf liner @ 2763'

11,000 Acid

Gas 7,195,000

R. Pr. 398#

TD 2763'

**COMPLETED**

Map No. \_\_\_\_\_ Sec. 6 Twp. 29 R. 33W

Well No. 1 Wheatley

United Prod. Company

**FIRST REPORT**

Contractor \_\_\_\_\_

NE SW

**SECTION PLAT**

100 Ft. from N. Line

\_\_\_\_\_ Ft. from S. Line

100 Ft. from E. Line

\_\_\_\_\_ Ft. from W. Line

	o		

Haskell County

Location X

Rig up \_\_\_\_\_

Drilling and Remarks:

**RECORD**

Cased \_\_\_\_\_ in., \_\_\_\_\_ ft.

Sand \_\_\_\_\_

Gas \_\_\_\_\_

Oil \_\_\_\_\_

Total Depth \_\_\_\_\_

**PRODUCTION**

1st 24 hrs. Nat. \_\_\_\_\_

1st 24 hrs. after shot \_\_\_\_\_

Gas \_\_\_\_\_ Cu. Ft.

Dry Hole \_\_\_\_\_

Abandoned \_\_\_\_\_

Date

OCT 8 1947 19

S. J. LEWIS Scout

*[Handwritten signature]*

Misc. Small Maps	<i>[initials]</i>
Cards	<i>Clare</i>
Tracing	
France Map	<i>[initials]</i>
Sarborough Map	<i>[initials]</i>
Justice Map	
Pierce Flat Book	

Map No. \_\_\_\_\_ Sec. 6 Twp. 29 R. 33W

Well No. 1 Wheatley

United Prod. Company

**COMPLETE**

Contractor

NE SW

*E 1,3005*

SECTION PLAT

100 Ft. from N. Line

\_\_\_\_\_ Ft. from S. Line

100 Ft. from E. Line

\_\_\_\_\_ Ft. from W. Line

	0		

Haskell County

RECORD

Location \_\_\_\_\_

Cased \_\_\_\_\_ in., \_\_\_\_\_ ft.

Rig up \_\_\_\_\_

Sand \_\_\_\_\_

Drilling and Remarks:

Gas \_\_\_\_\_

Oil \_\_\_\_\_

Total Depth 2762

=====

PRODUCTION

1st 24 hrs. Nat. \_\_\_\_\_

1st 24 hrs. after shot \_\_\_\_\_

Gas \_\_\_\_\_ Cu. Ft.

Dry Hole \_\_\_\_\_

Abandoned \_\_\_\_\_

*7" @ 2601*  
*186' 4" of 5" Pipe Line*  
*@ 2762*  
*11000 acid*  
*7,195,000 gal*  
*398<sup>th</sup> R/L*

Date

MAR 31 1948 19 \_\_\_\_\_ S. J. LEWIS Scout

Misc. Small Maps

Cards \_\_\_\_\_

Traci \_\_\_\_\_

France Map \_\_\_\_\_

Scarborough Map \_\_\_\_\_

Pierce Map \_\_\_\_\_

Geological Dept. \_\_\_\_\_

Pierce Plat Book \_\_\_\_\_